


① FRONT PERSPECTIVE

LIST OF DRAWINGS

ARCHITECTURAL DRAWINGS

- T1.1 TITLE SHEET
- A1.1 FIRST FLOOR
- A1.2 ROOF FRAMING PLAN & ROOF PLAN
- A2.1 ELEVATIONS

23 PORPOISE RUN, SOUTHERN SHORES, NORTH CAROLINA

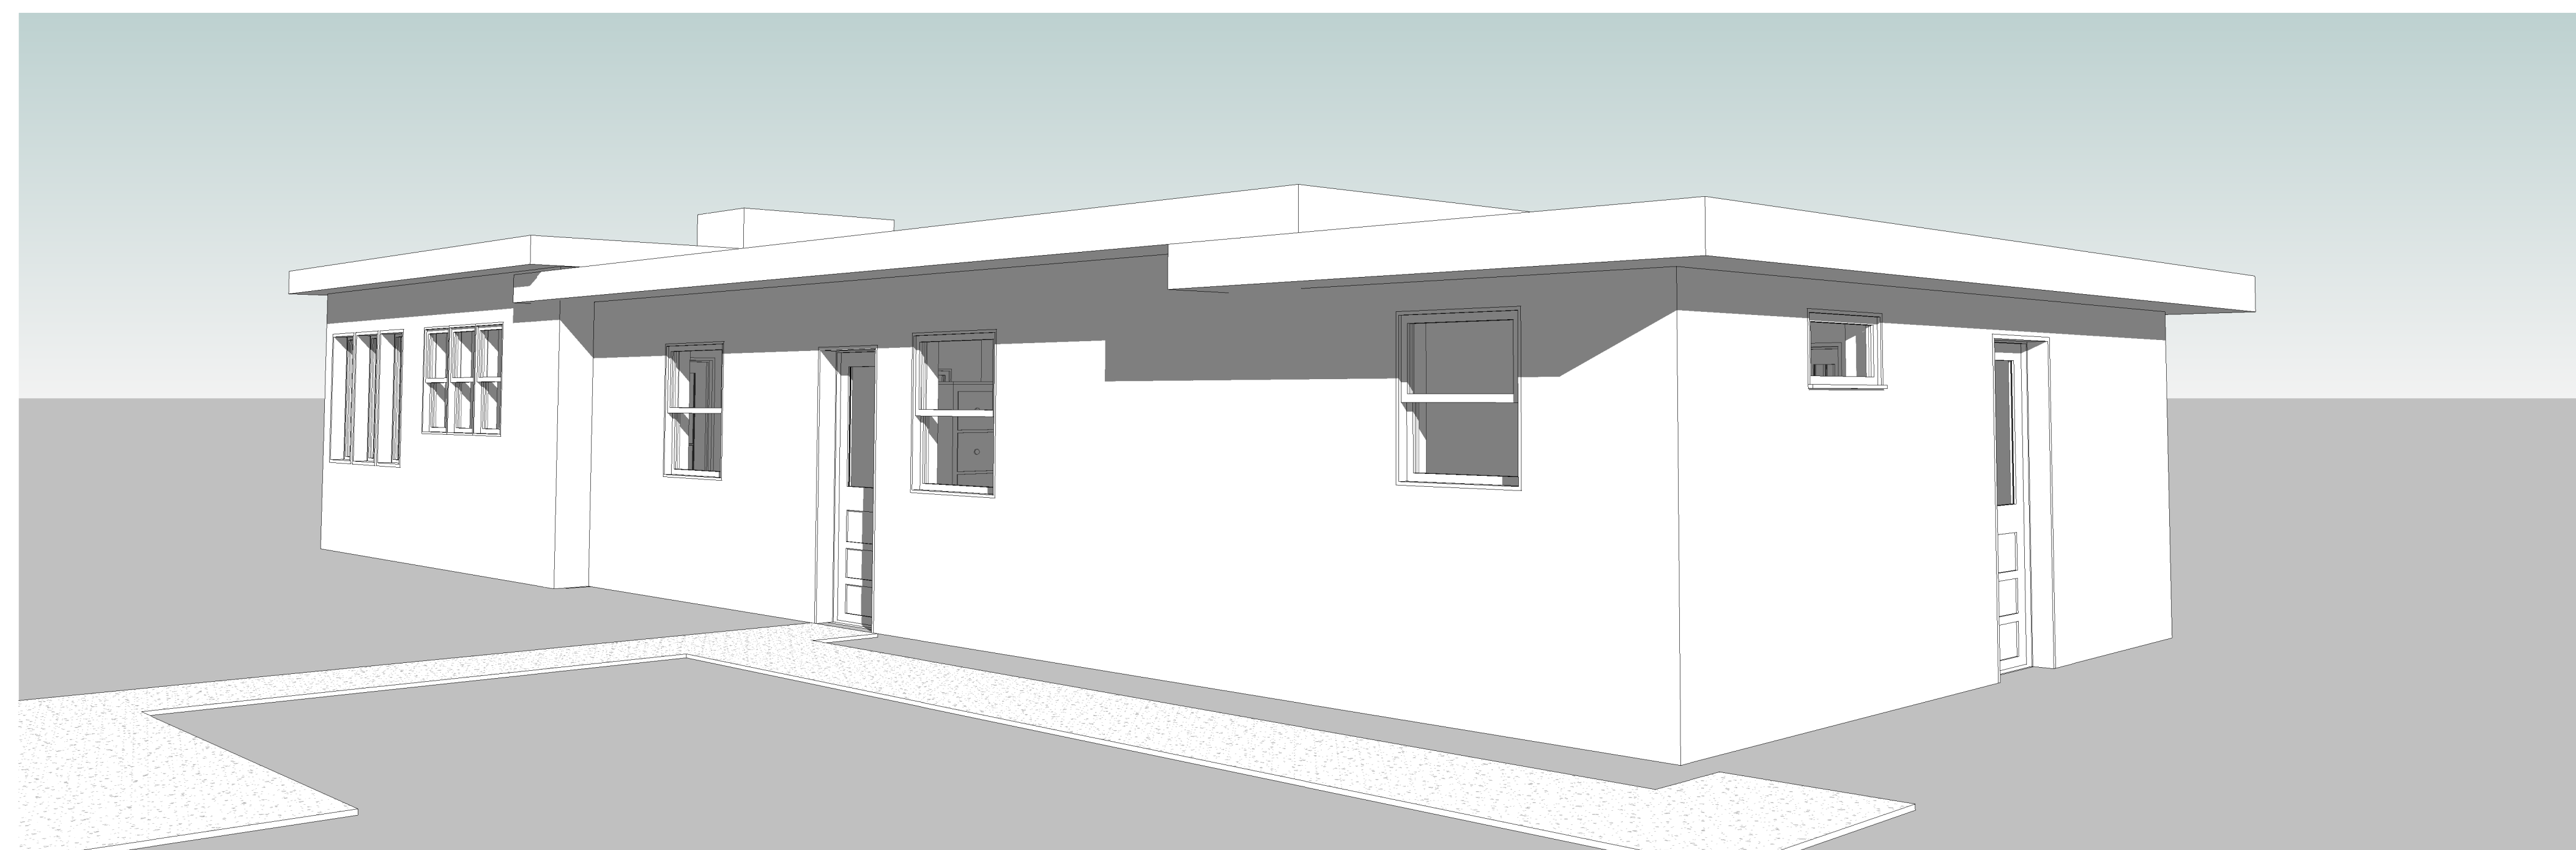

② FRONT PERSPECTIVE 2

PROJECT NAME:

23 PORPOISE RUN
SOUTHERN SHORES
NORTH CAROLINA

REVISIONS:	DATE:
AS-BUILTS	5 / 10 / 19

DRAWING NAME:

TITLE SHEET

PRELIMINARY DRAWINGS
NOT FOR
CONSTRUCTION:

DRAWN BY: DF


DATE: 5 / 10 / 19

SCALE: SEE PLANS

STAMP:

SHEET:

T1.1

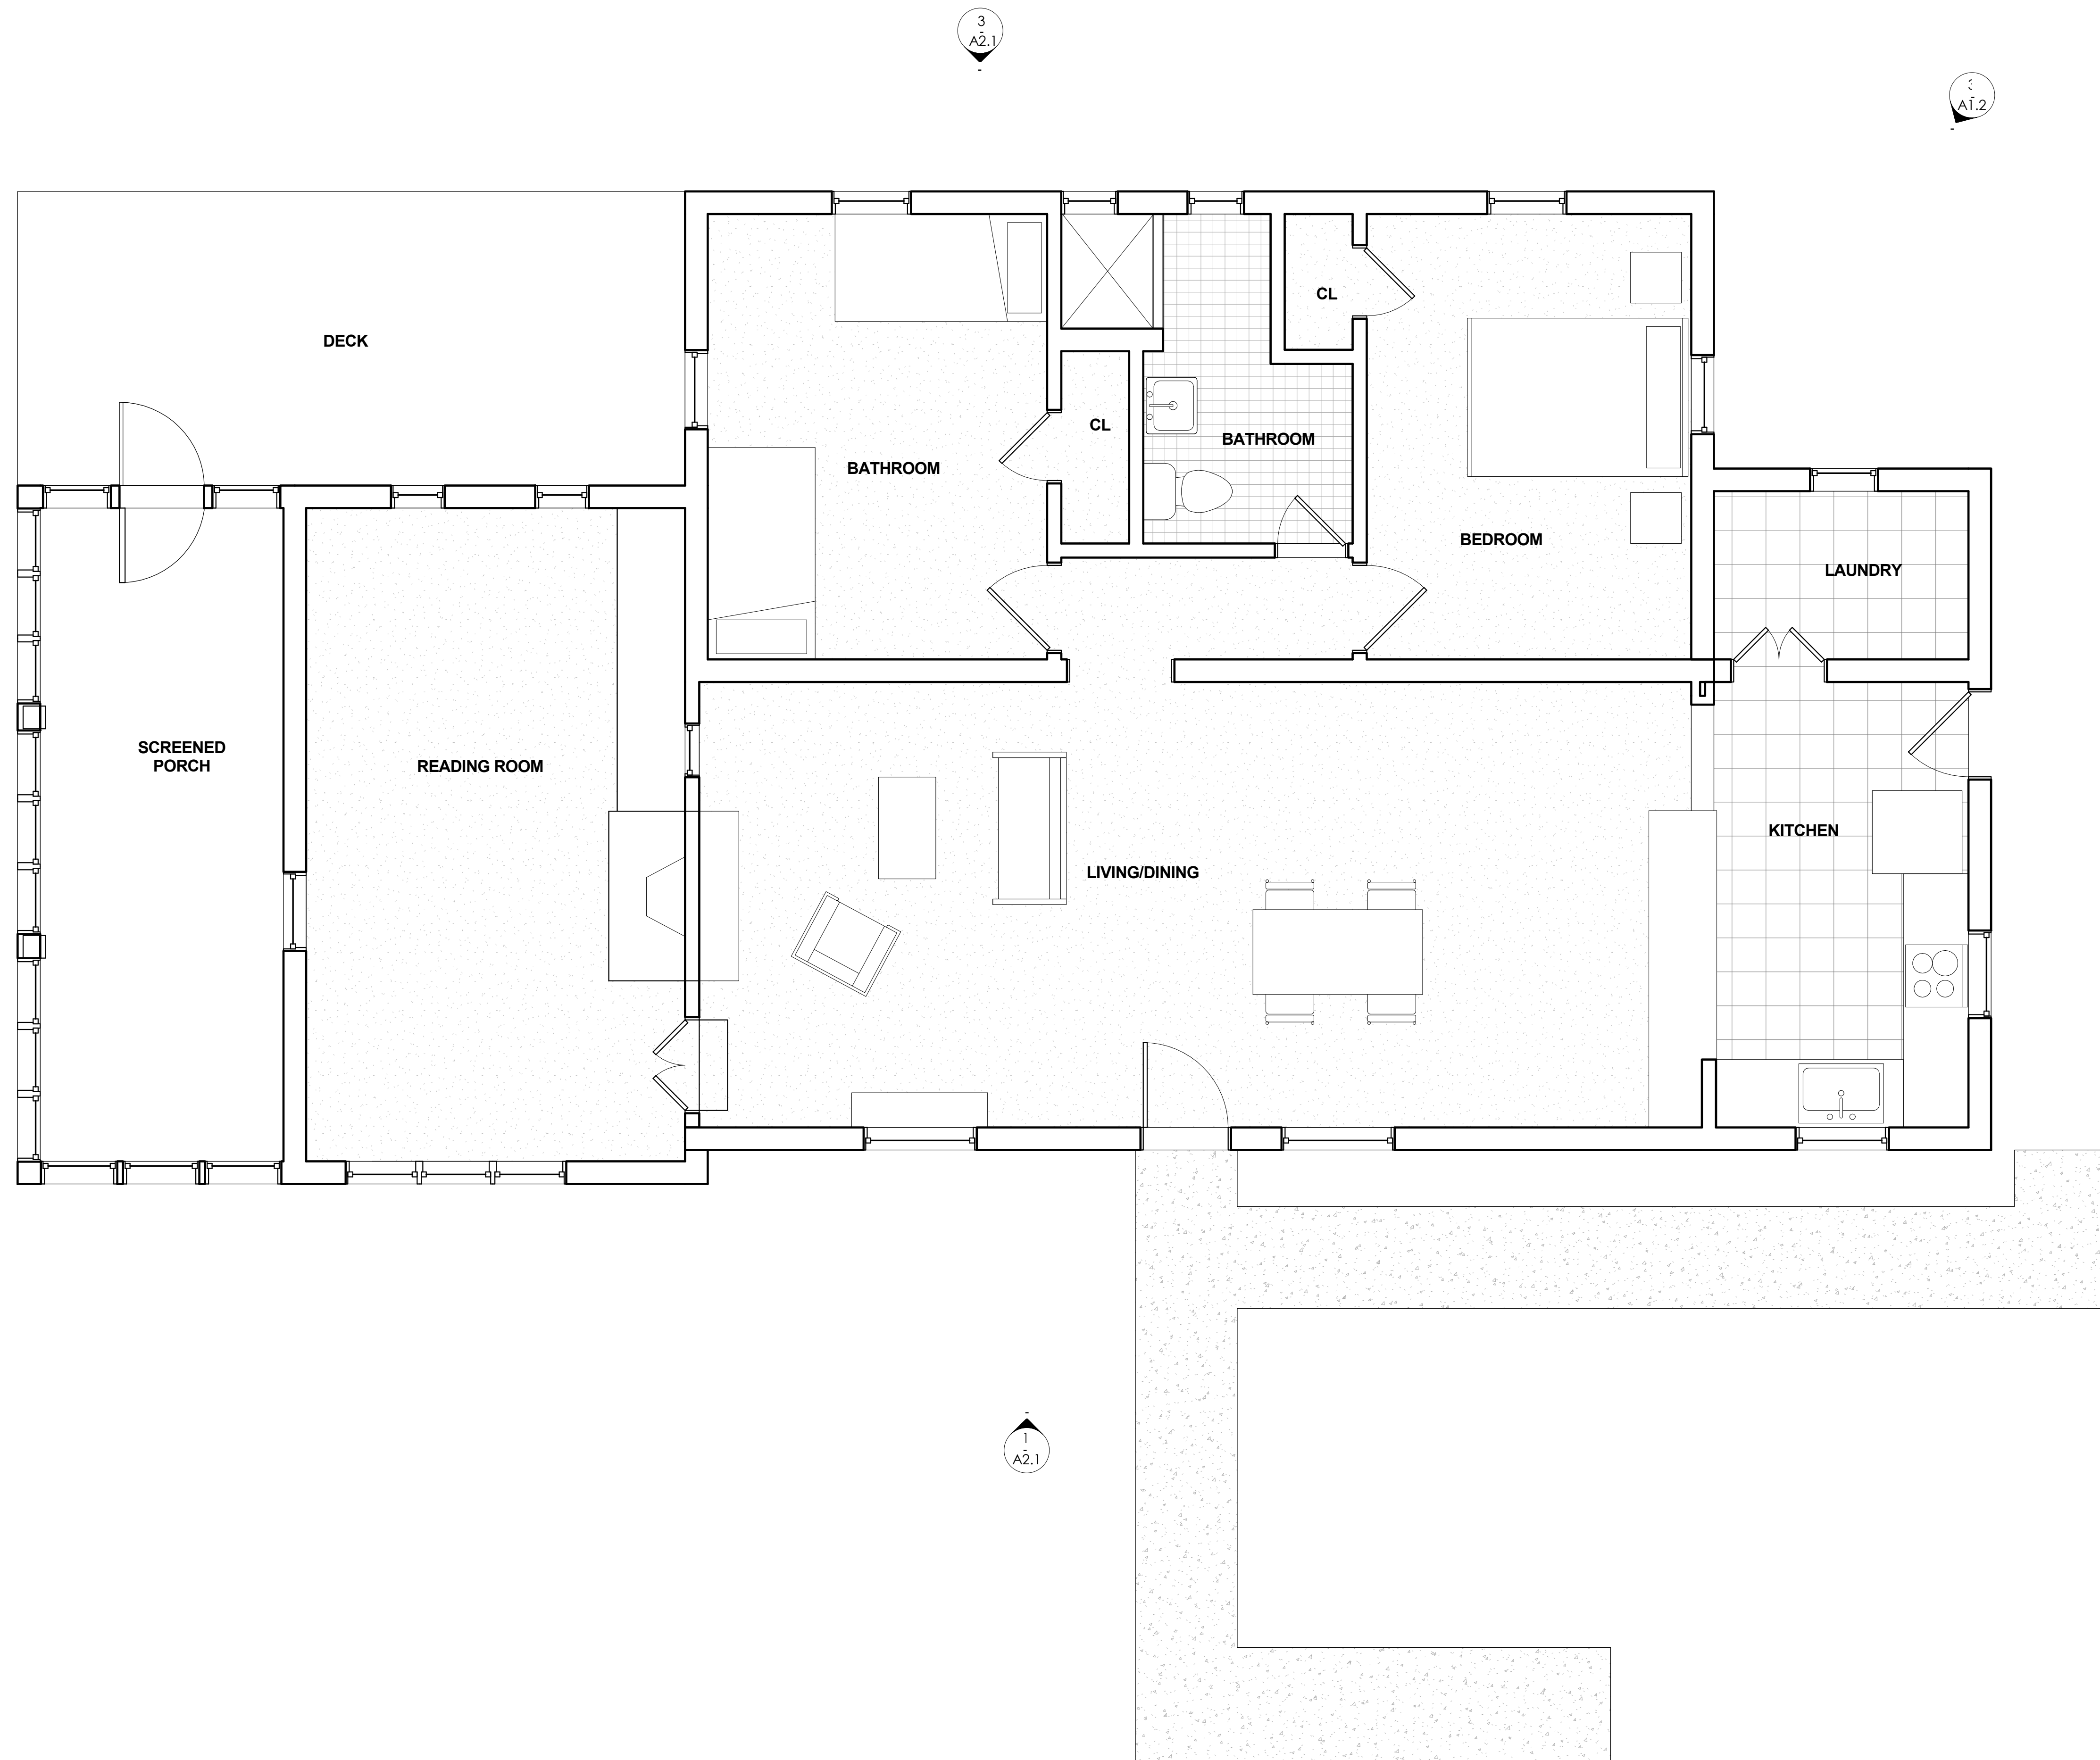

1 FIRST FLOOR PLAN
3/8" = 1'-0"

PROJECT NAME:

23 PORPOISE RUN
SOUTHERN SHORES
NORTH CAROLINA

REVISIONS:	DATE:
AS-BUILTS	5 / 10 / 19

DRAWING NAME:

FIRST FLOOR
PLAN

PRELIMINARY DRAWINGS
NOT FOR
CONSTRUCTION:

DRAWN BY: DF


DATE: 5 / 10 / 19

SCALE: SEE PLANS

STAMP:

SHEET:

A1.1

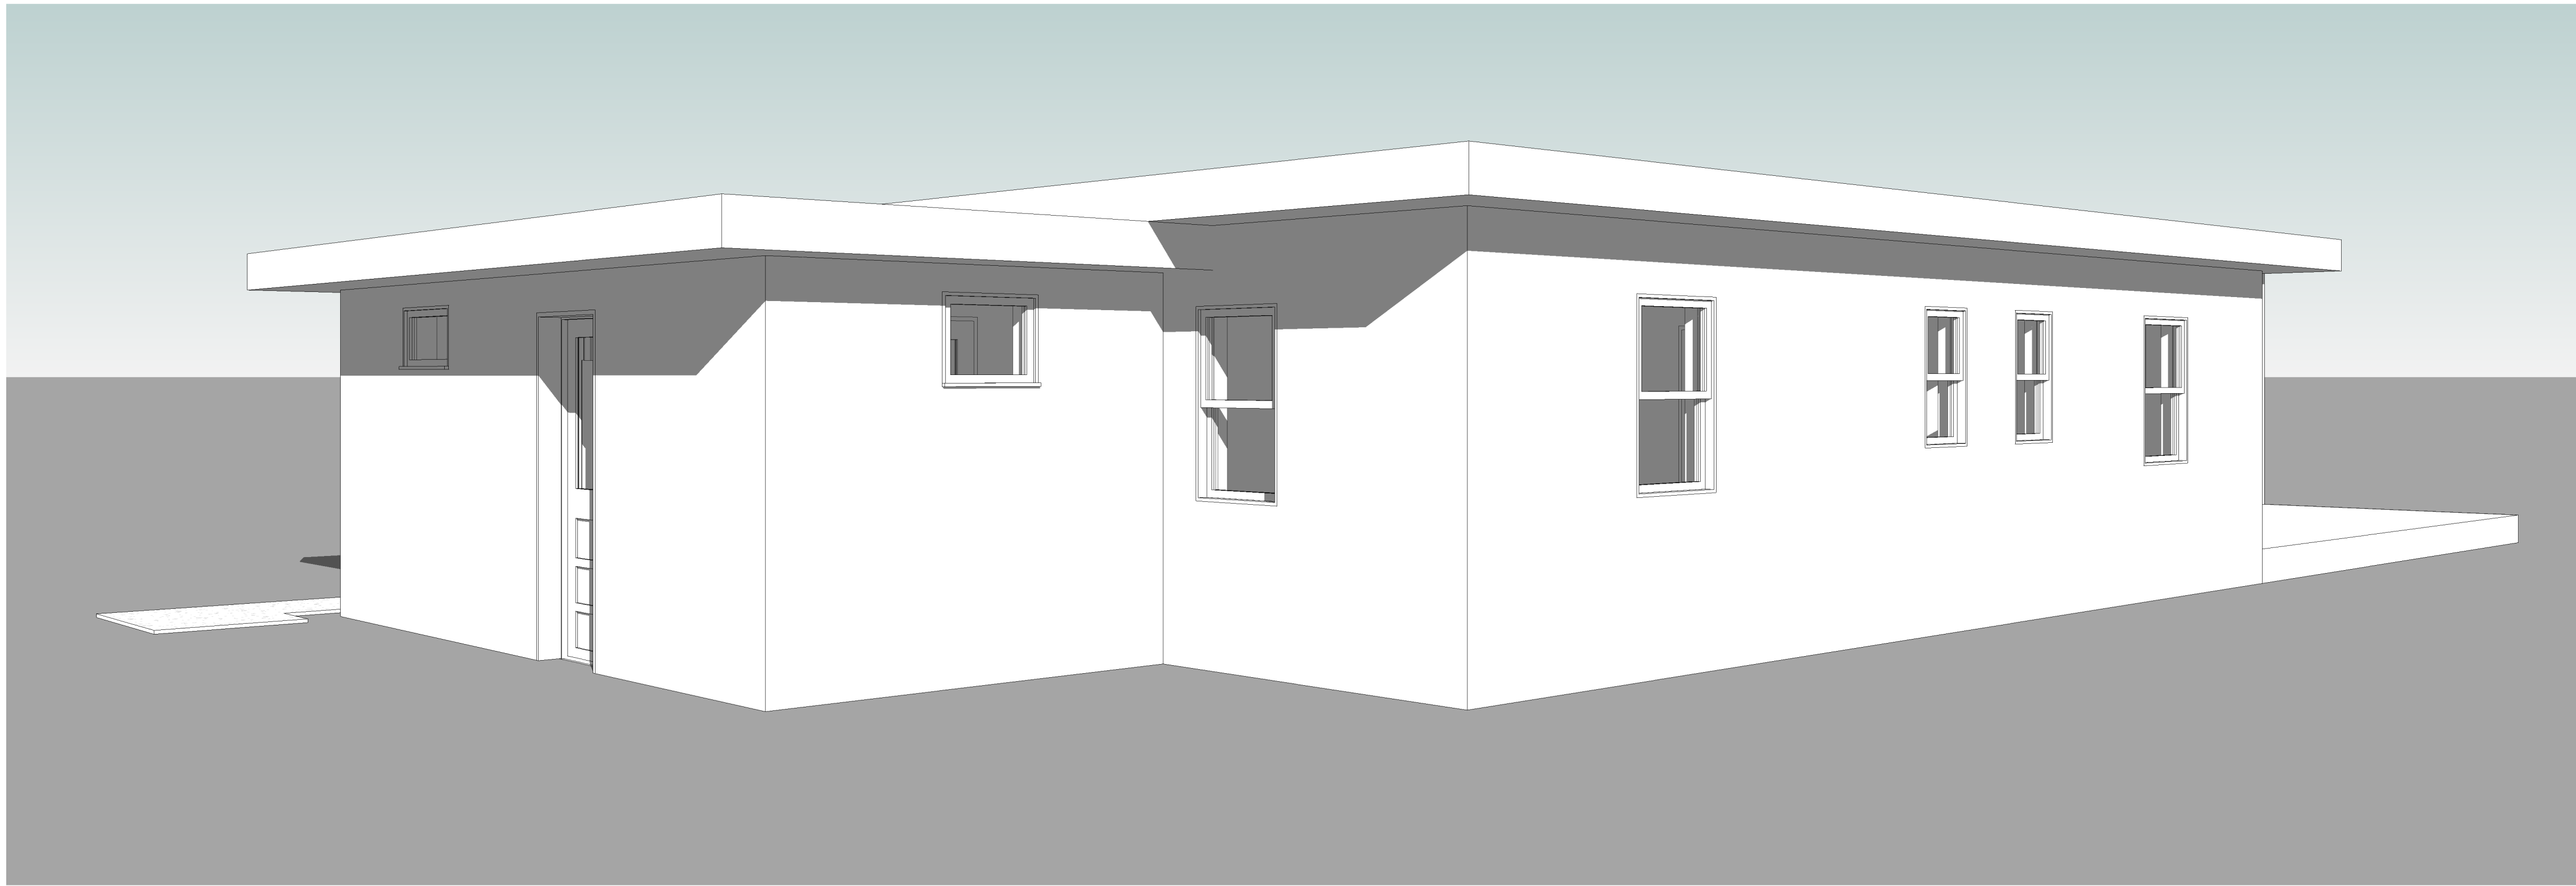

③ BACK PERSPECTIVE

PROJECT NAME:

23 PORPOISE RUN
SOUTHERN SHORES
NORTH CAROLINA

REVISIONS:	DATE:
AS-BUILTS	5 / 10 / 19

DRAWING NAME:

ROOF
FRAMING PLAN

PRELIMINARY DRAWINGS
NOT FOR
CONSTRUCTION:

DRAWN BY: DF


DATE: 5 / 10 / 19

SCALE: SEE PLANS


STAMP:

SHEET:


A1.2

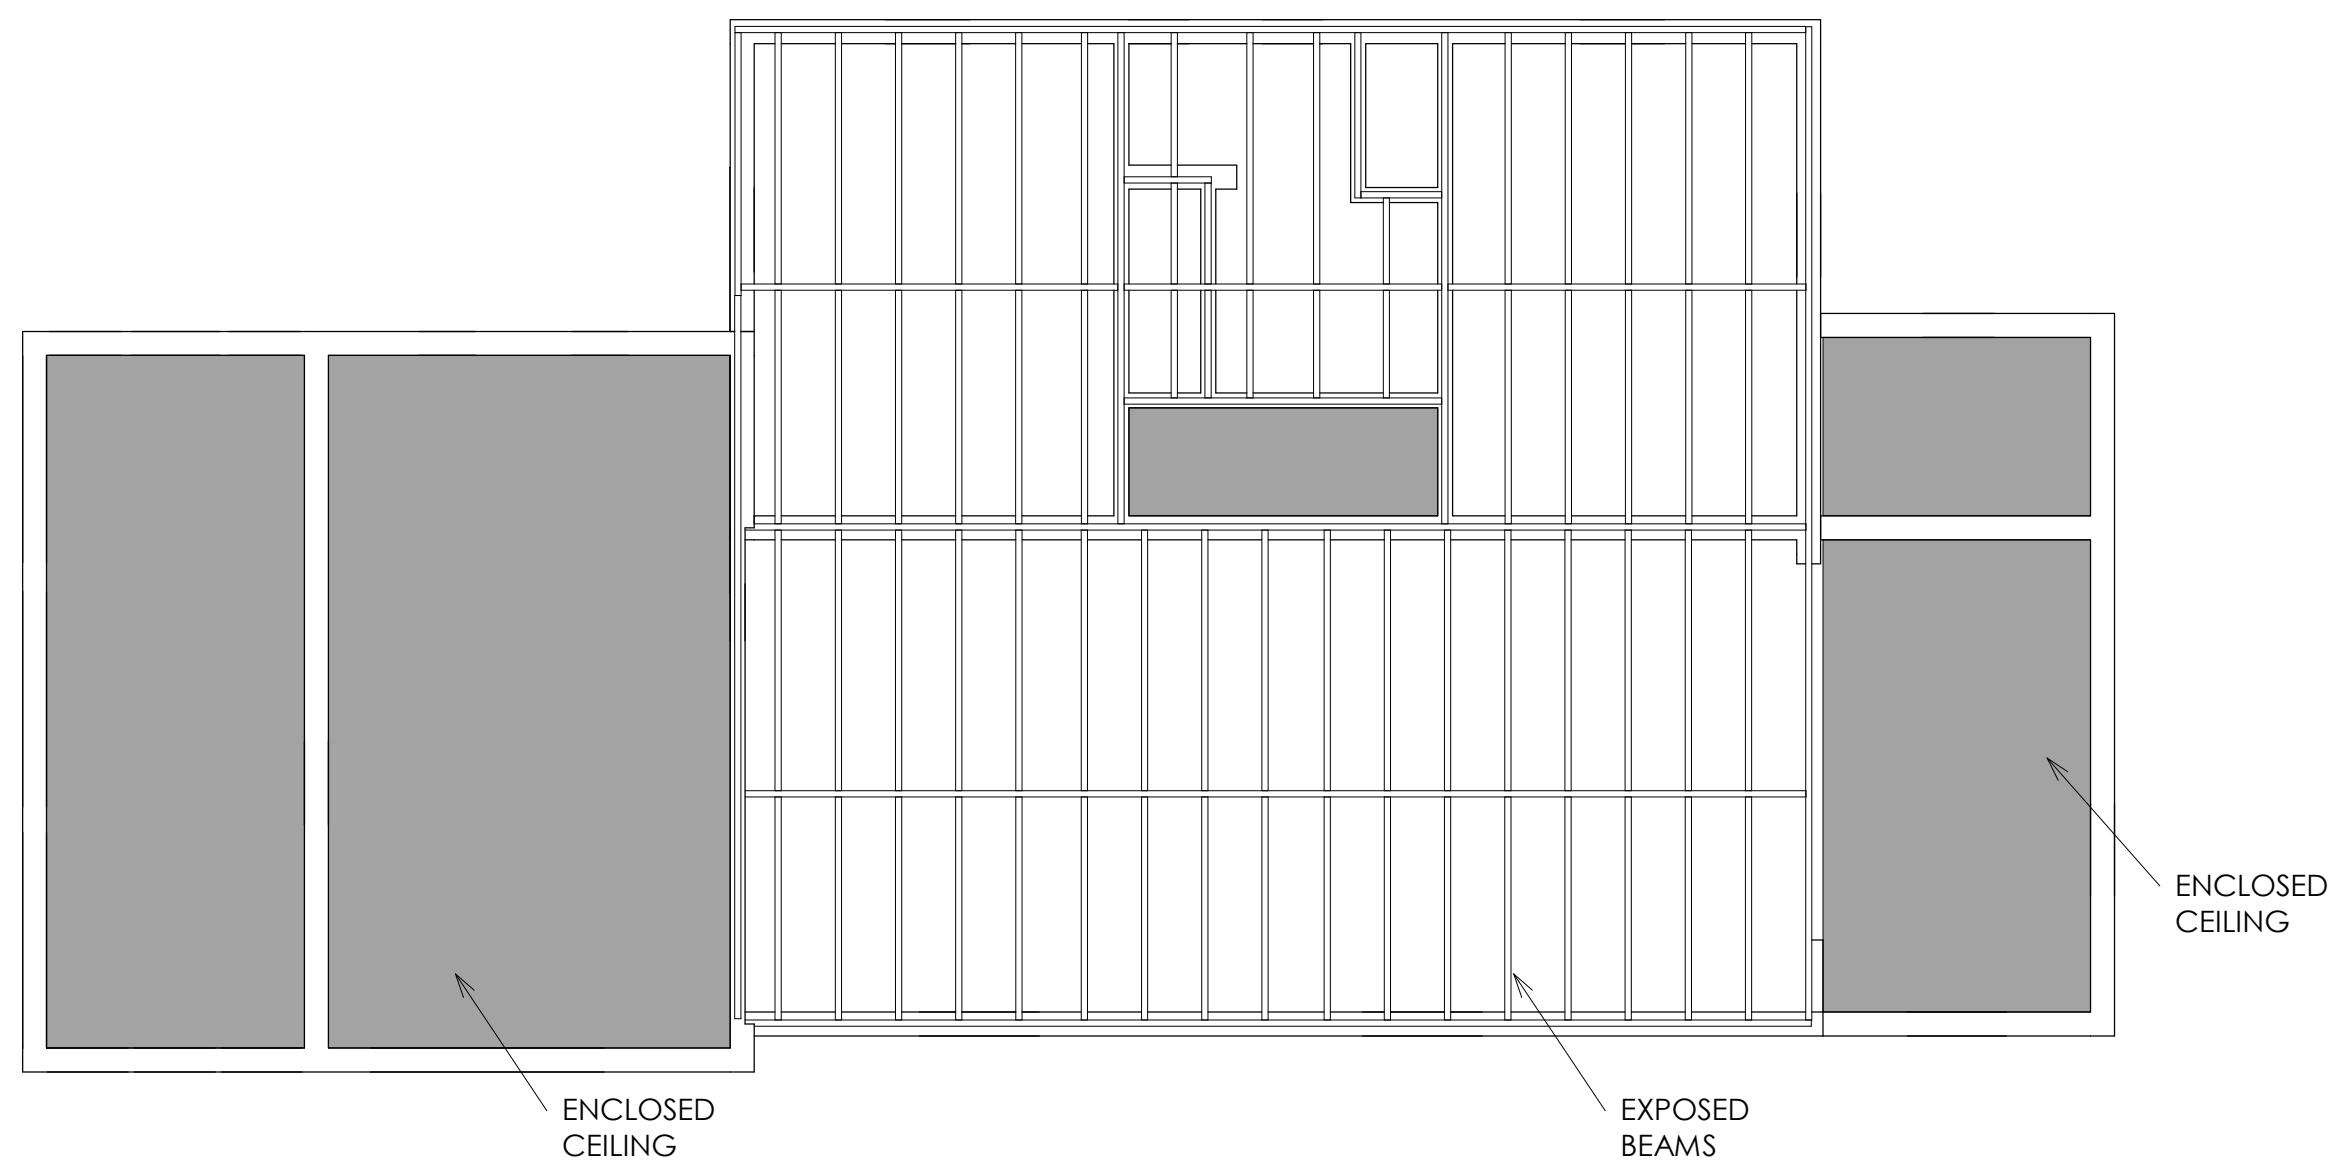


① ROOF FRAMING PLAN
3/16" = 1'-0"

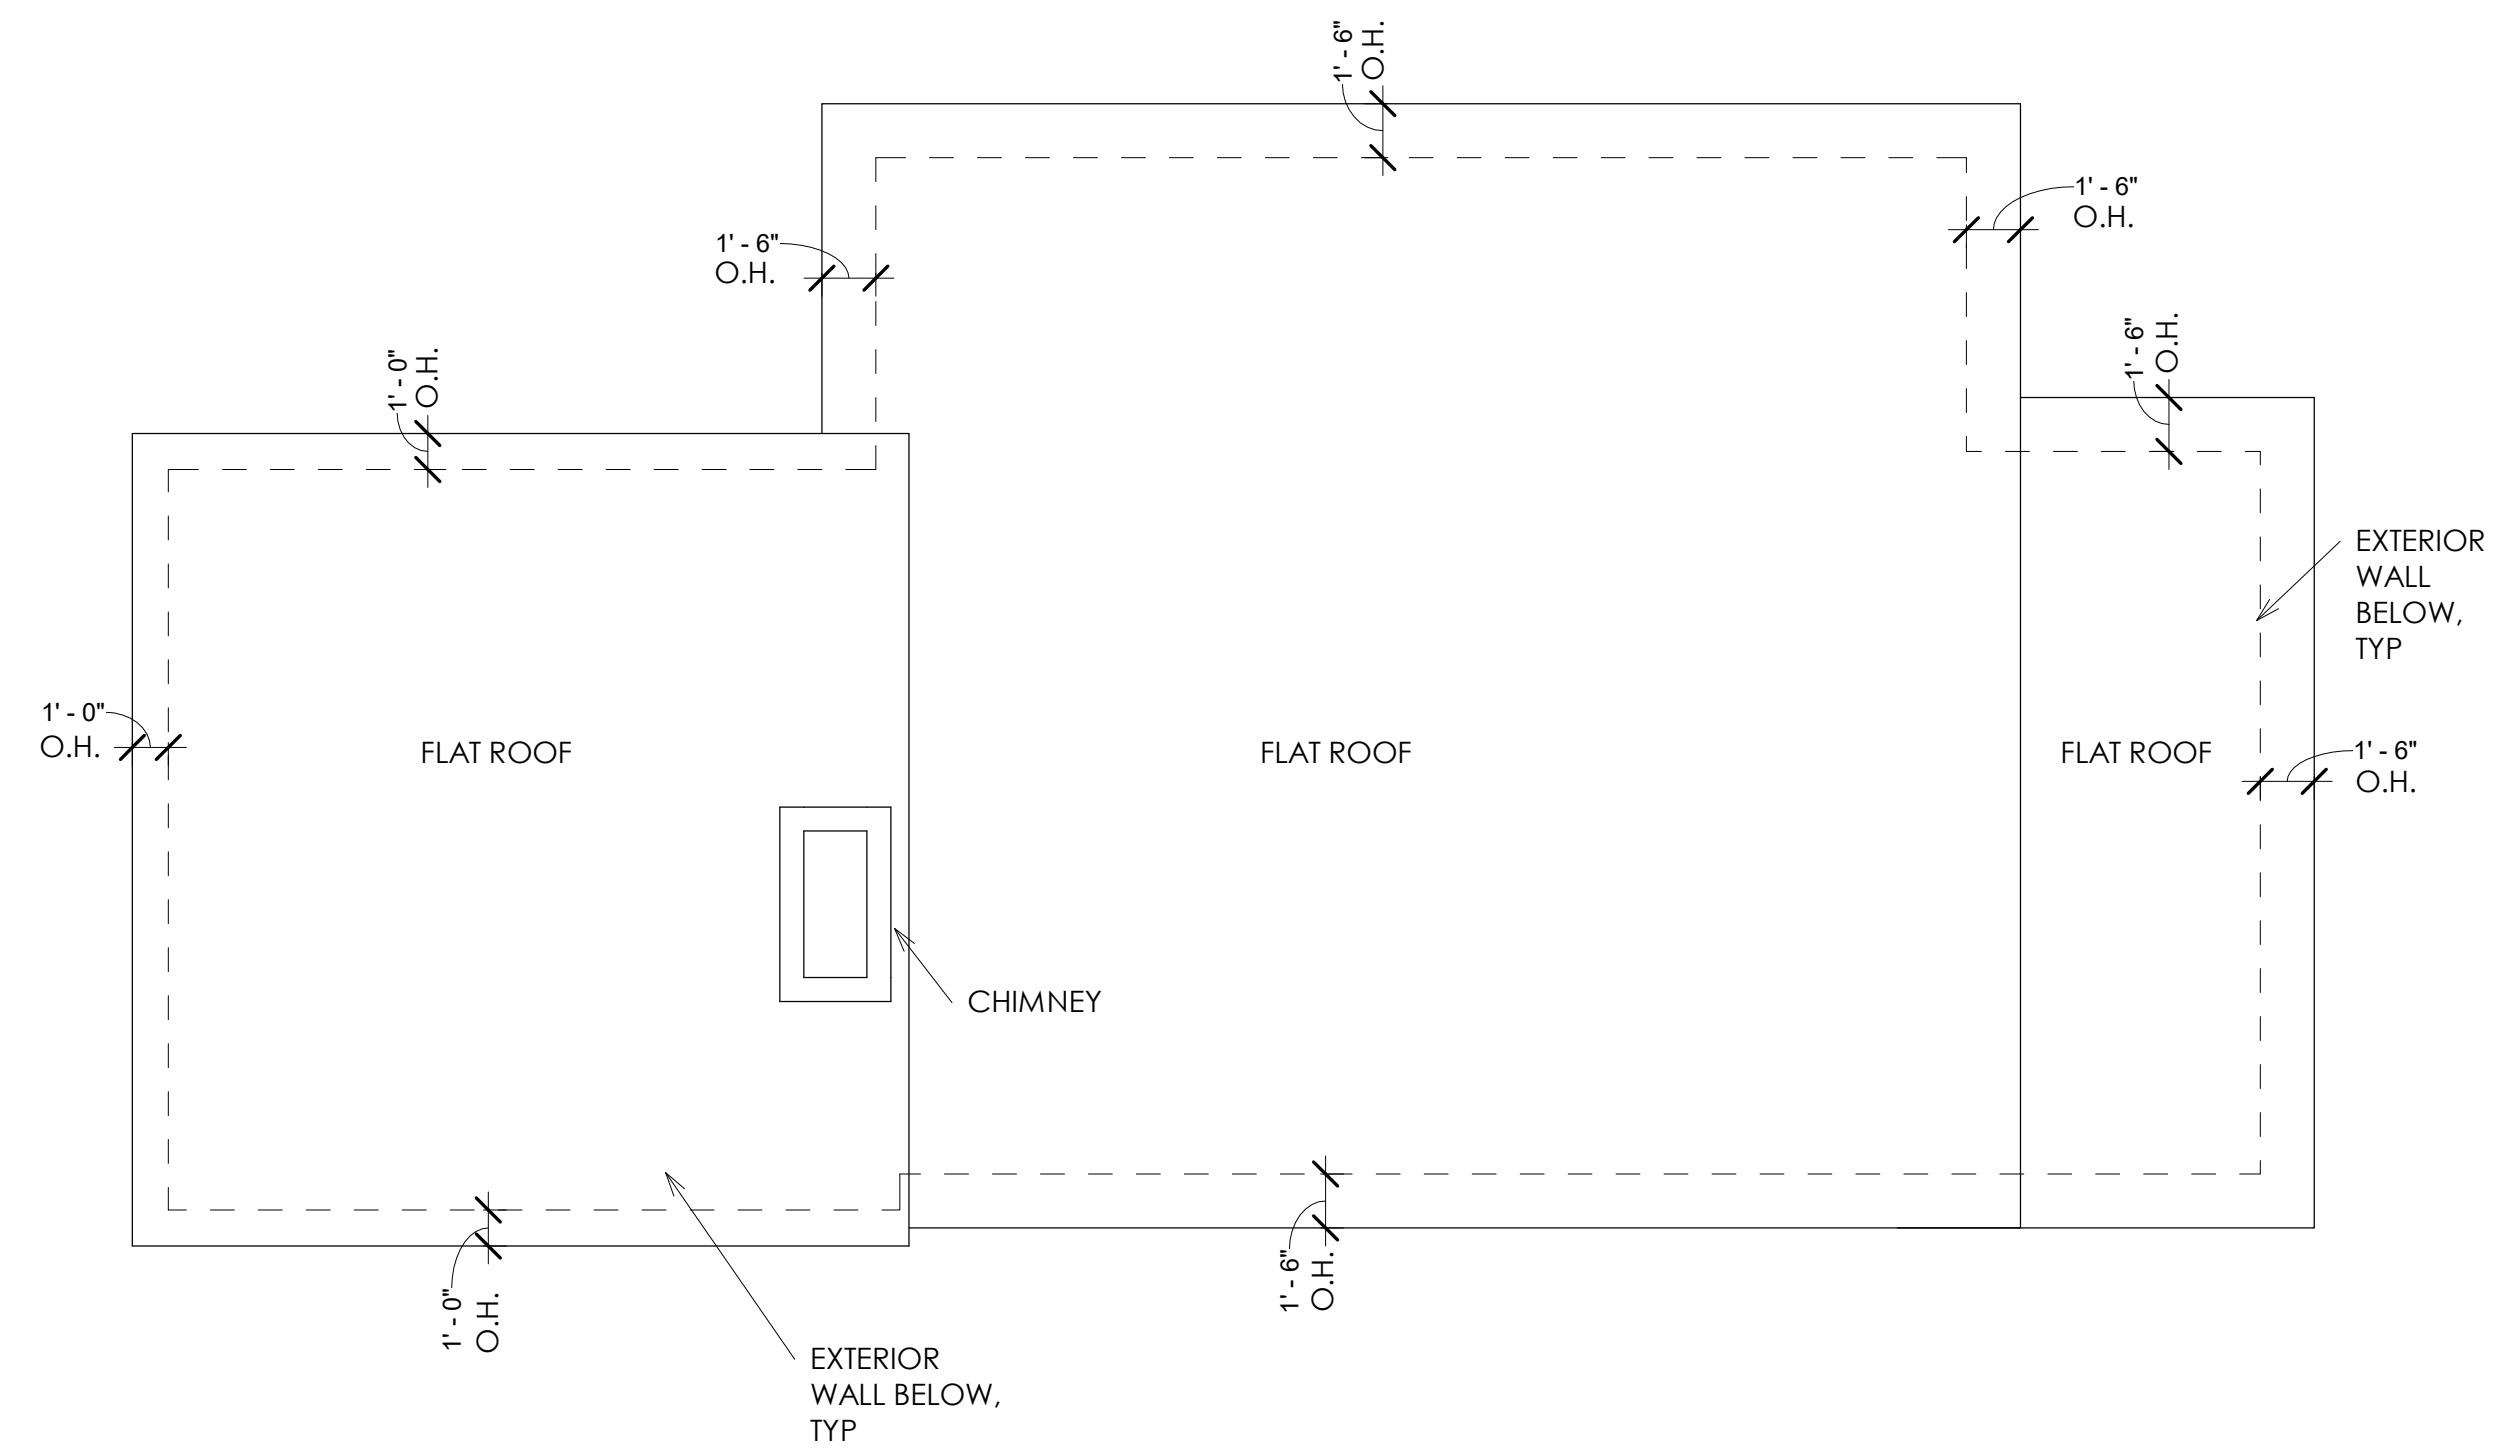


② ROOF PLAN
3/16" = 1'-0"

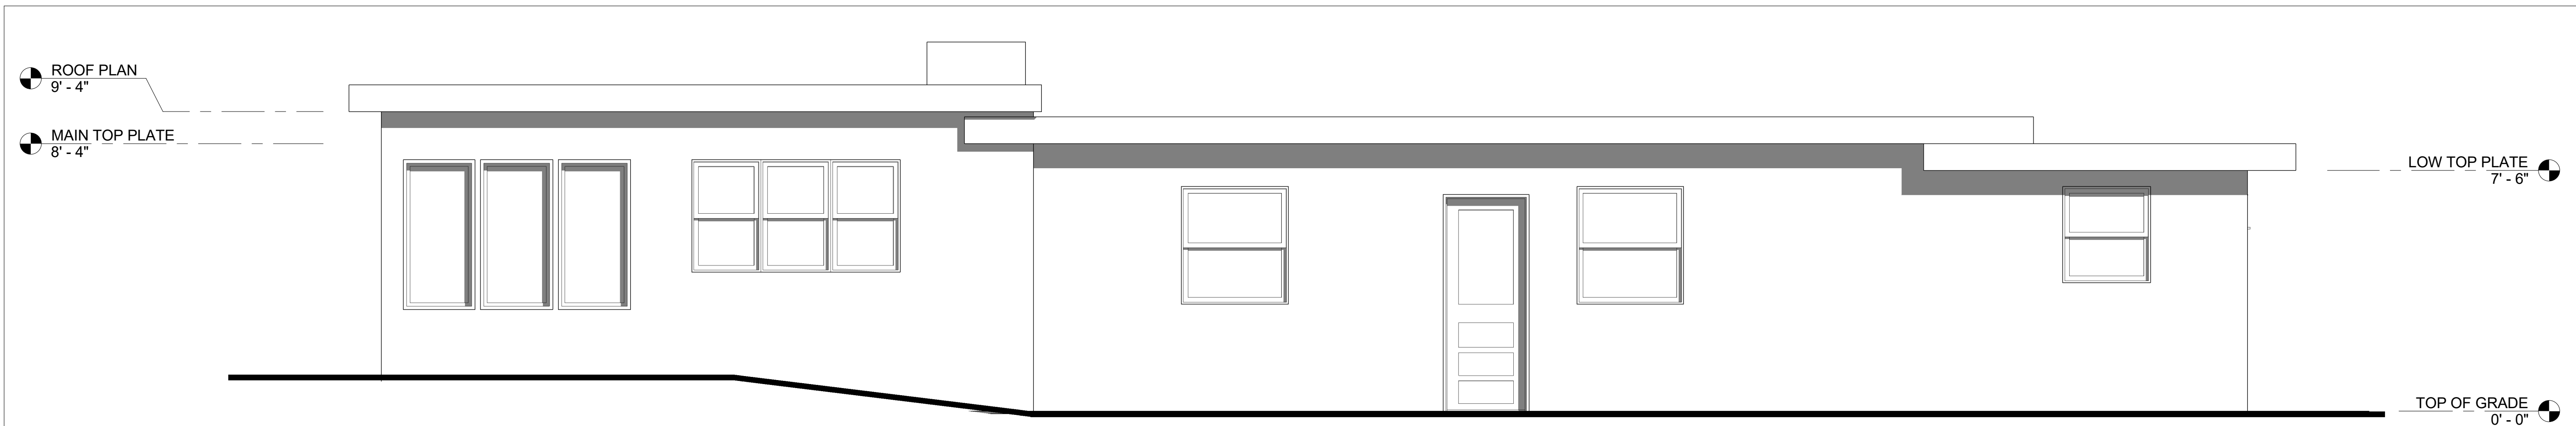


1 EXTERIOR ELEVATION 1
3/8" = 1'-0"

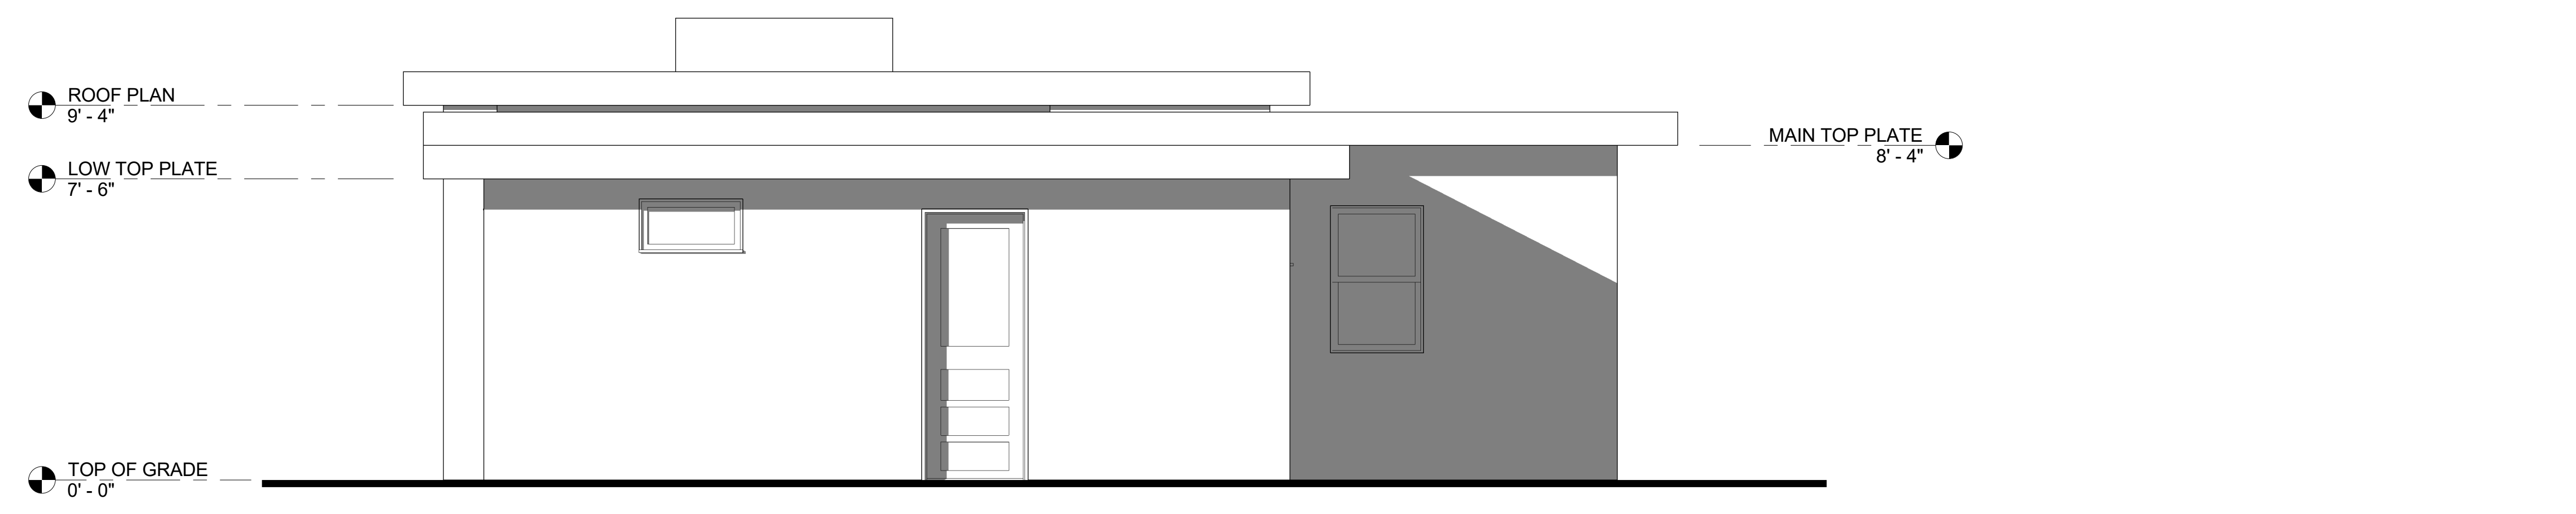

2 EXTERIOR ELEVATION 2
3/8" = 1'-0"

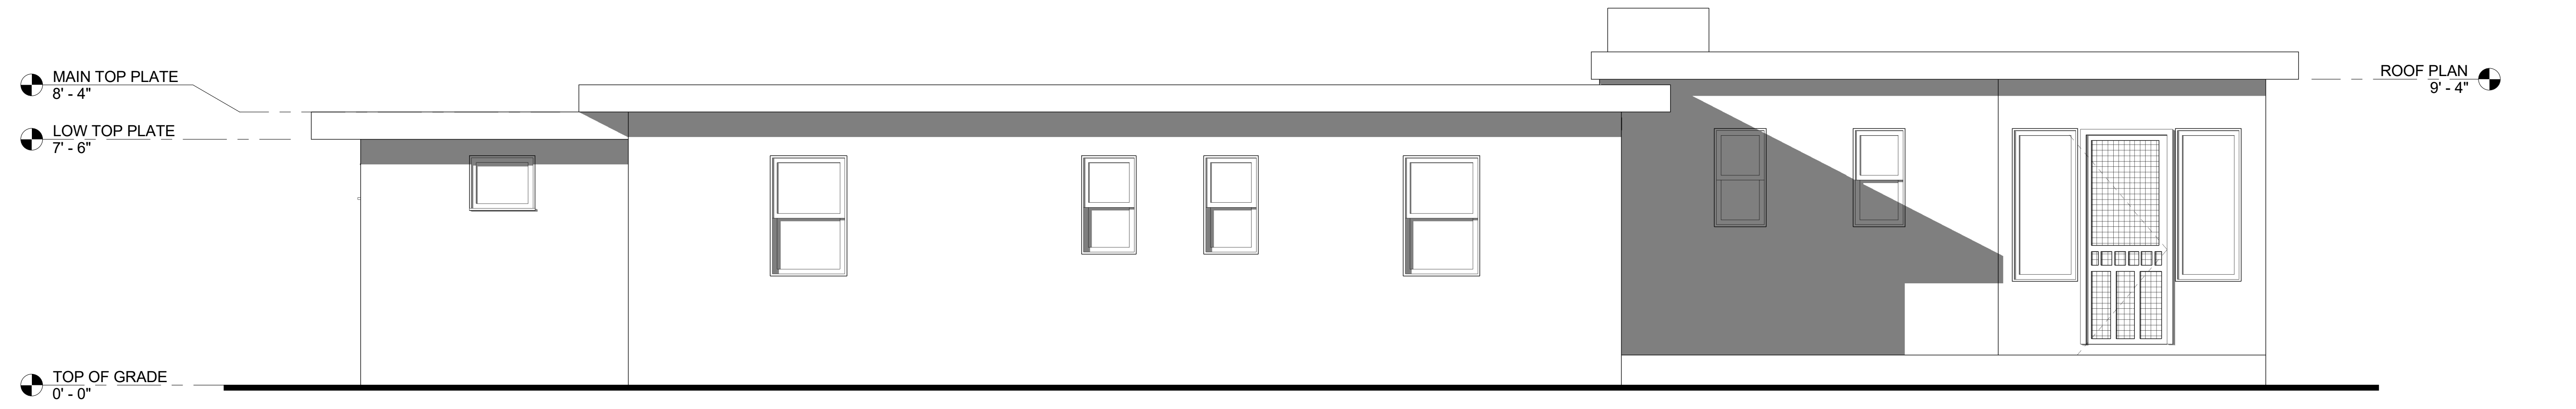

3 EXTERIOR ELEVATION 3
3/8" = 1'-0"

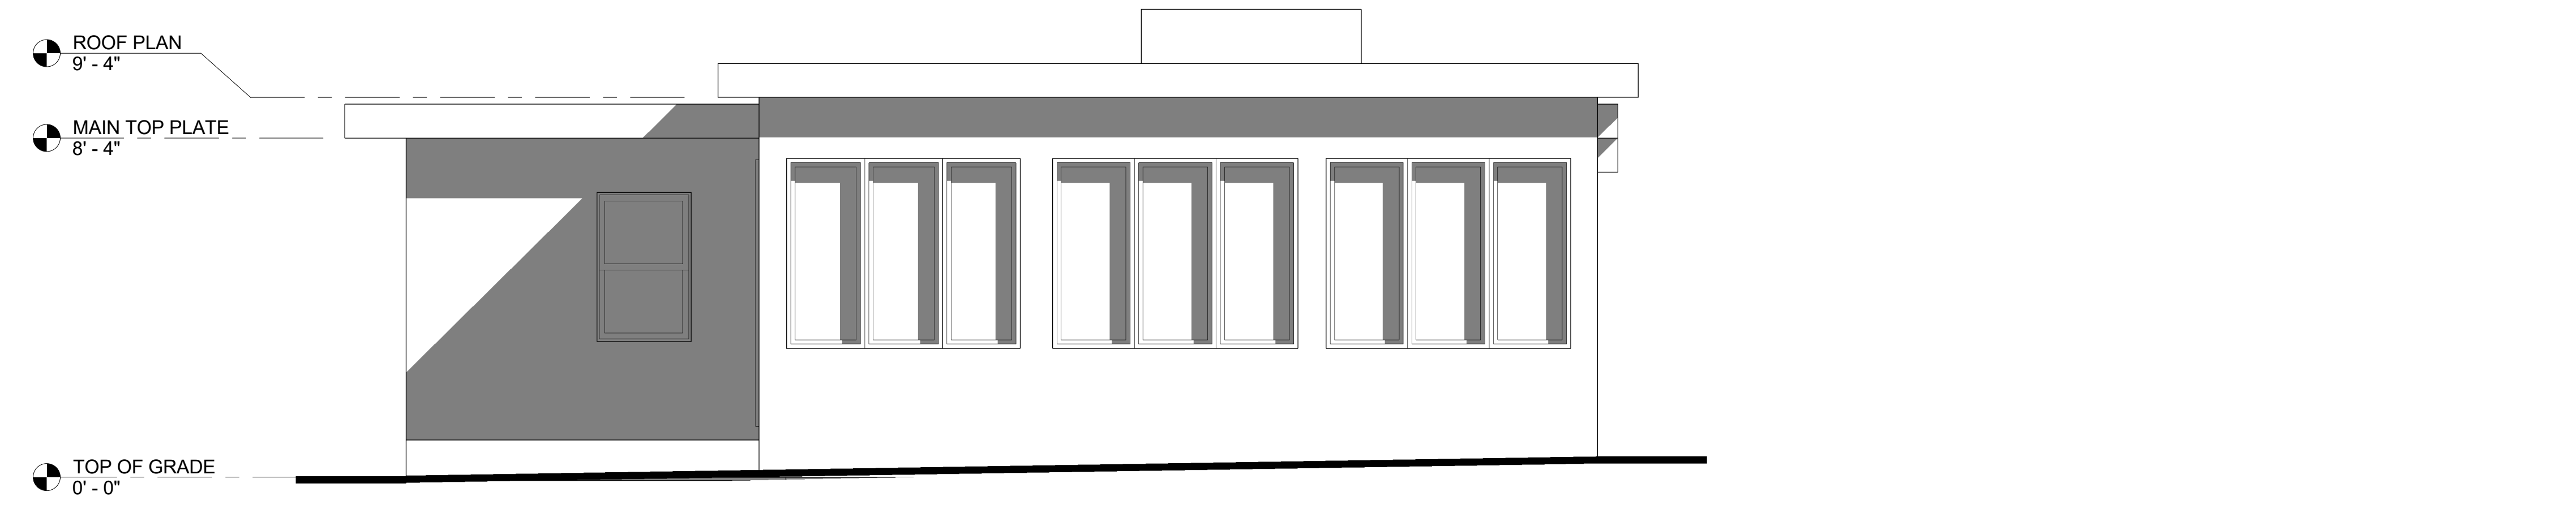

4 EXTERIOR ELEVATION 4
3/8" = 1'-0"

PROJECT NAME:

23 PORPOISE RUN
SOUTHERN SHORES
NORTH CAROLINA

REVISIONS:	DATE:
AS-BUILTS	5 / 10 / 19

DRAWING NAME:
ELEVATIONS

PRELIMINARY DRAWINGS
NOT FOR
CONSTRUCTION:

DRAWN BY: DF

DATE: 5 / 10 / 19

SCALE: SEE PLANS

STAMP:

SHEET:
A2.1