


# PERKINSON'S COTTAGE

142 OCEAN BLVD, SOUTHERN SHORES,  
 NORTH CAROLINA

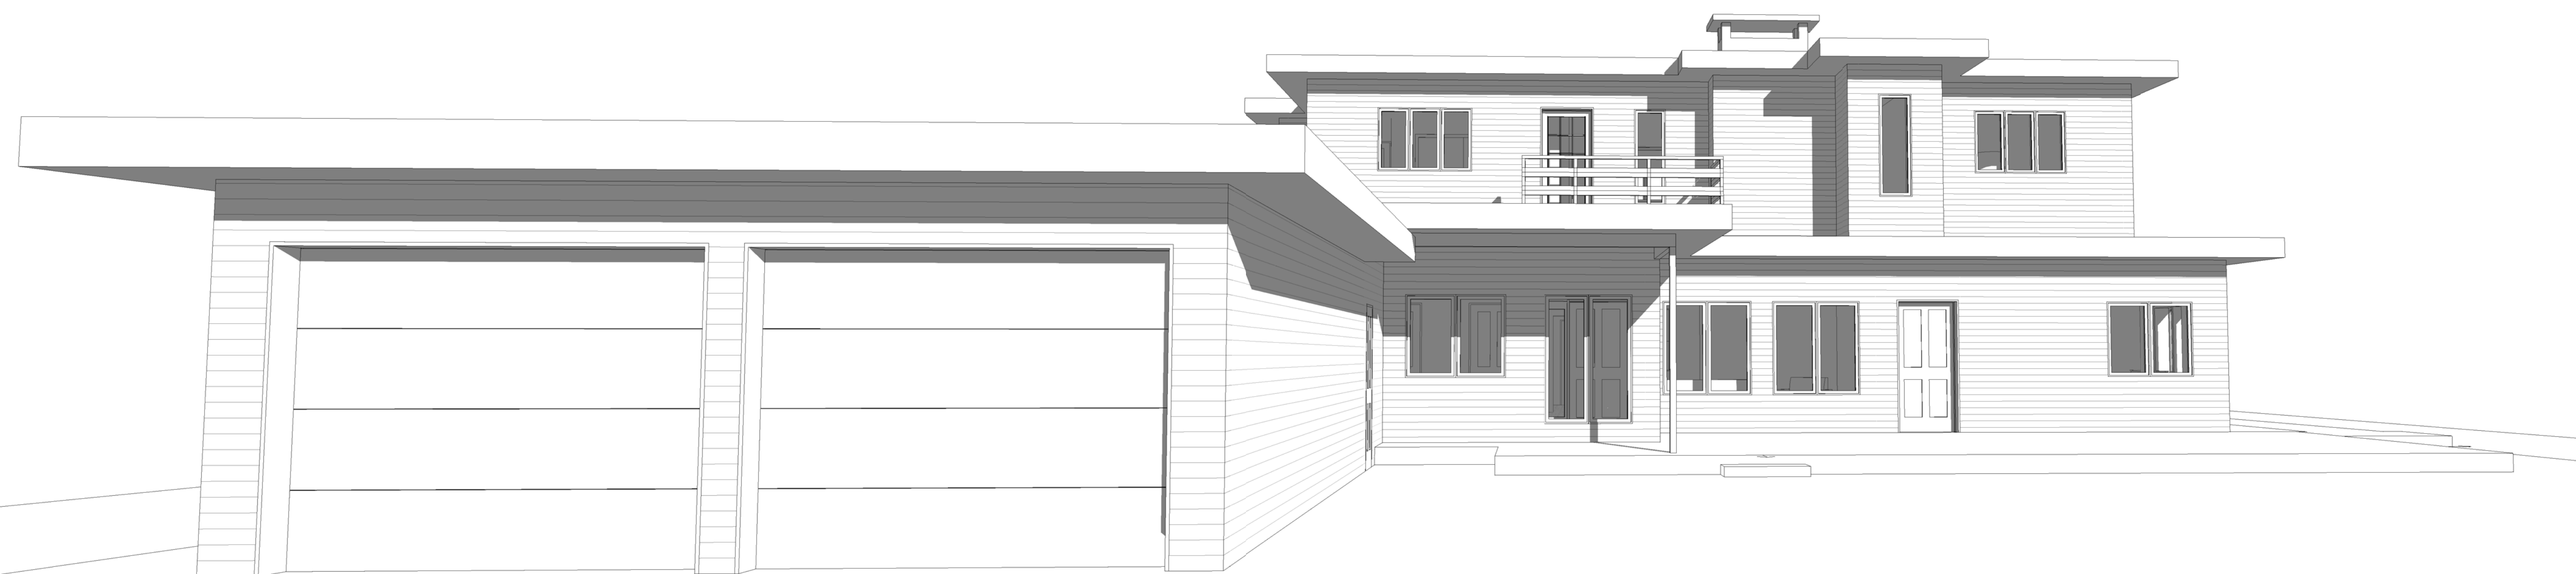

② WEST PERSPECTIVE

PROJECT NAME:  
**PERKINSON'S  
 COTTAGE**  
 142 OCEAN BLVD  
 SOUTHERN SHORES  
 NORTH CAROLINA

REVISIONS:	DATE:
AS-BUILTS	9/11/17

DRAWING NAME:  
**TITLE SHEET**

PRELIMINARY DRAWINGS  
 NOT FOR  
 CONSTRUCTION:

DRAWN BY: JT

DATE: 9/11/17

SCALE: SEE PLANS

STAMP:

© 2017 BEACON ARCHITECTURE +  
 DESIGN  
 P.L.L.C. - ALL RIGHTS RESERVED

SHEET:  
**T1.1**

- ## LIST OF DRAWINGS
- ARCHITECTURAL DRAWINGS
- T1.1 TITLE SHEET
  - A1.1 FIRST AND SECOND FLOOR PLAN
  - A1.2 ROOF PLAN
  - A2.1 ELEVATIONS WEST/SOUTH
  - A2.2 ELEVATIONS EAST/NORTH

PROJECT NAME:  
**PERKINSON'S COTTAGE**  
 142 OCEAN BLVD  
 SOUTHERN SHORES  
 NORTH CAROLINA

REVISIONS:	DATE:
AS- BUILTS	9/11/17

DRAWING NAME:  
**FIRST AND SECOND FLOOR PLAN**

PRELIMINARY DRAWINGS  
 NOT FOR  
 CONSTRUCTION:

DRAWN BY: JT

DATE: 9/11/17


SCALE: SEE PLANS

STAMP:


© 2017 BEACON ARCHITECTURE + DESIGN P.L.L.C. - ALL RIGHTS RESERVED

SHEET:

**A1.1**

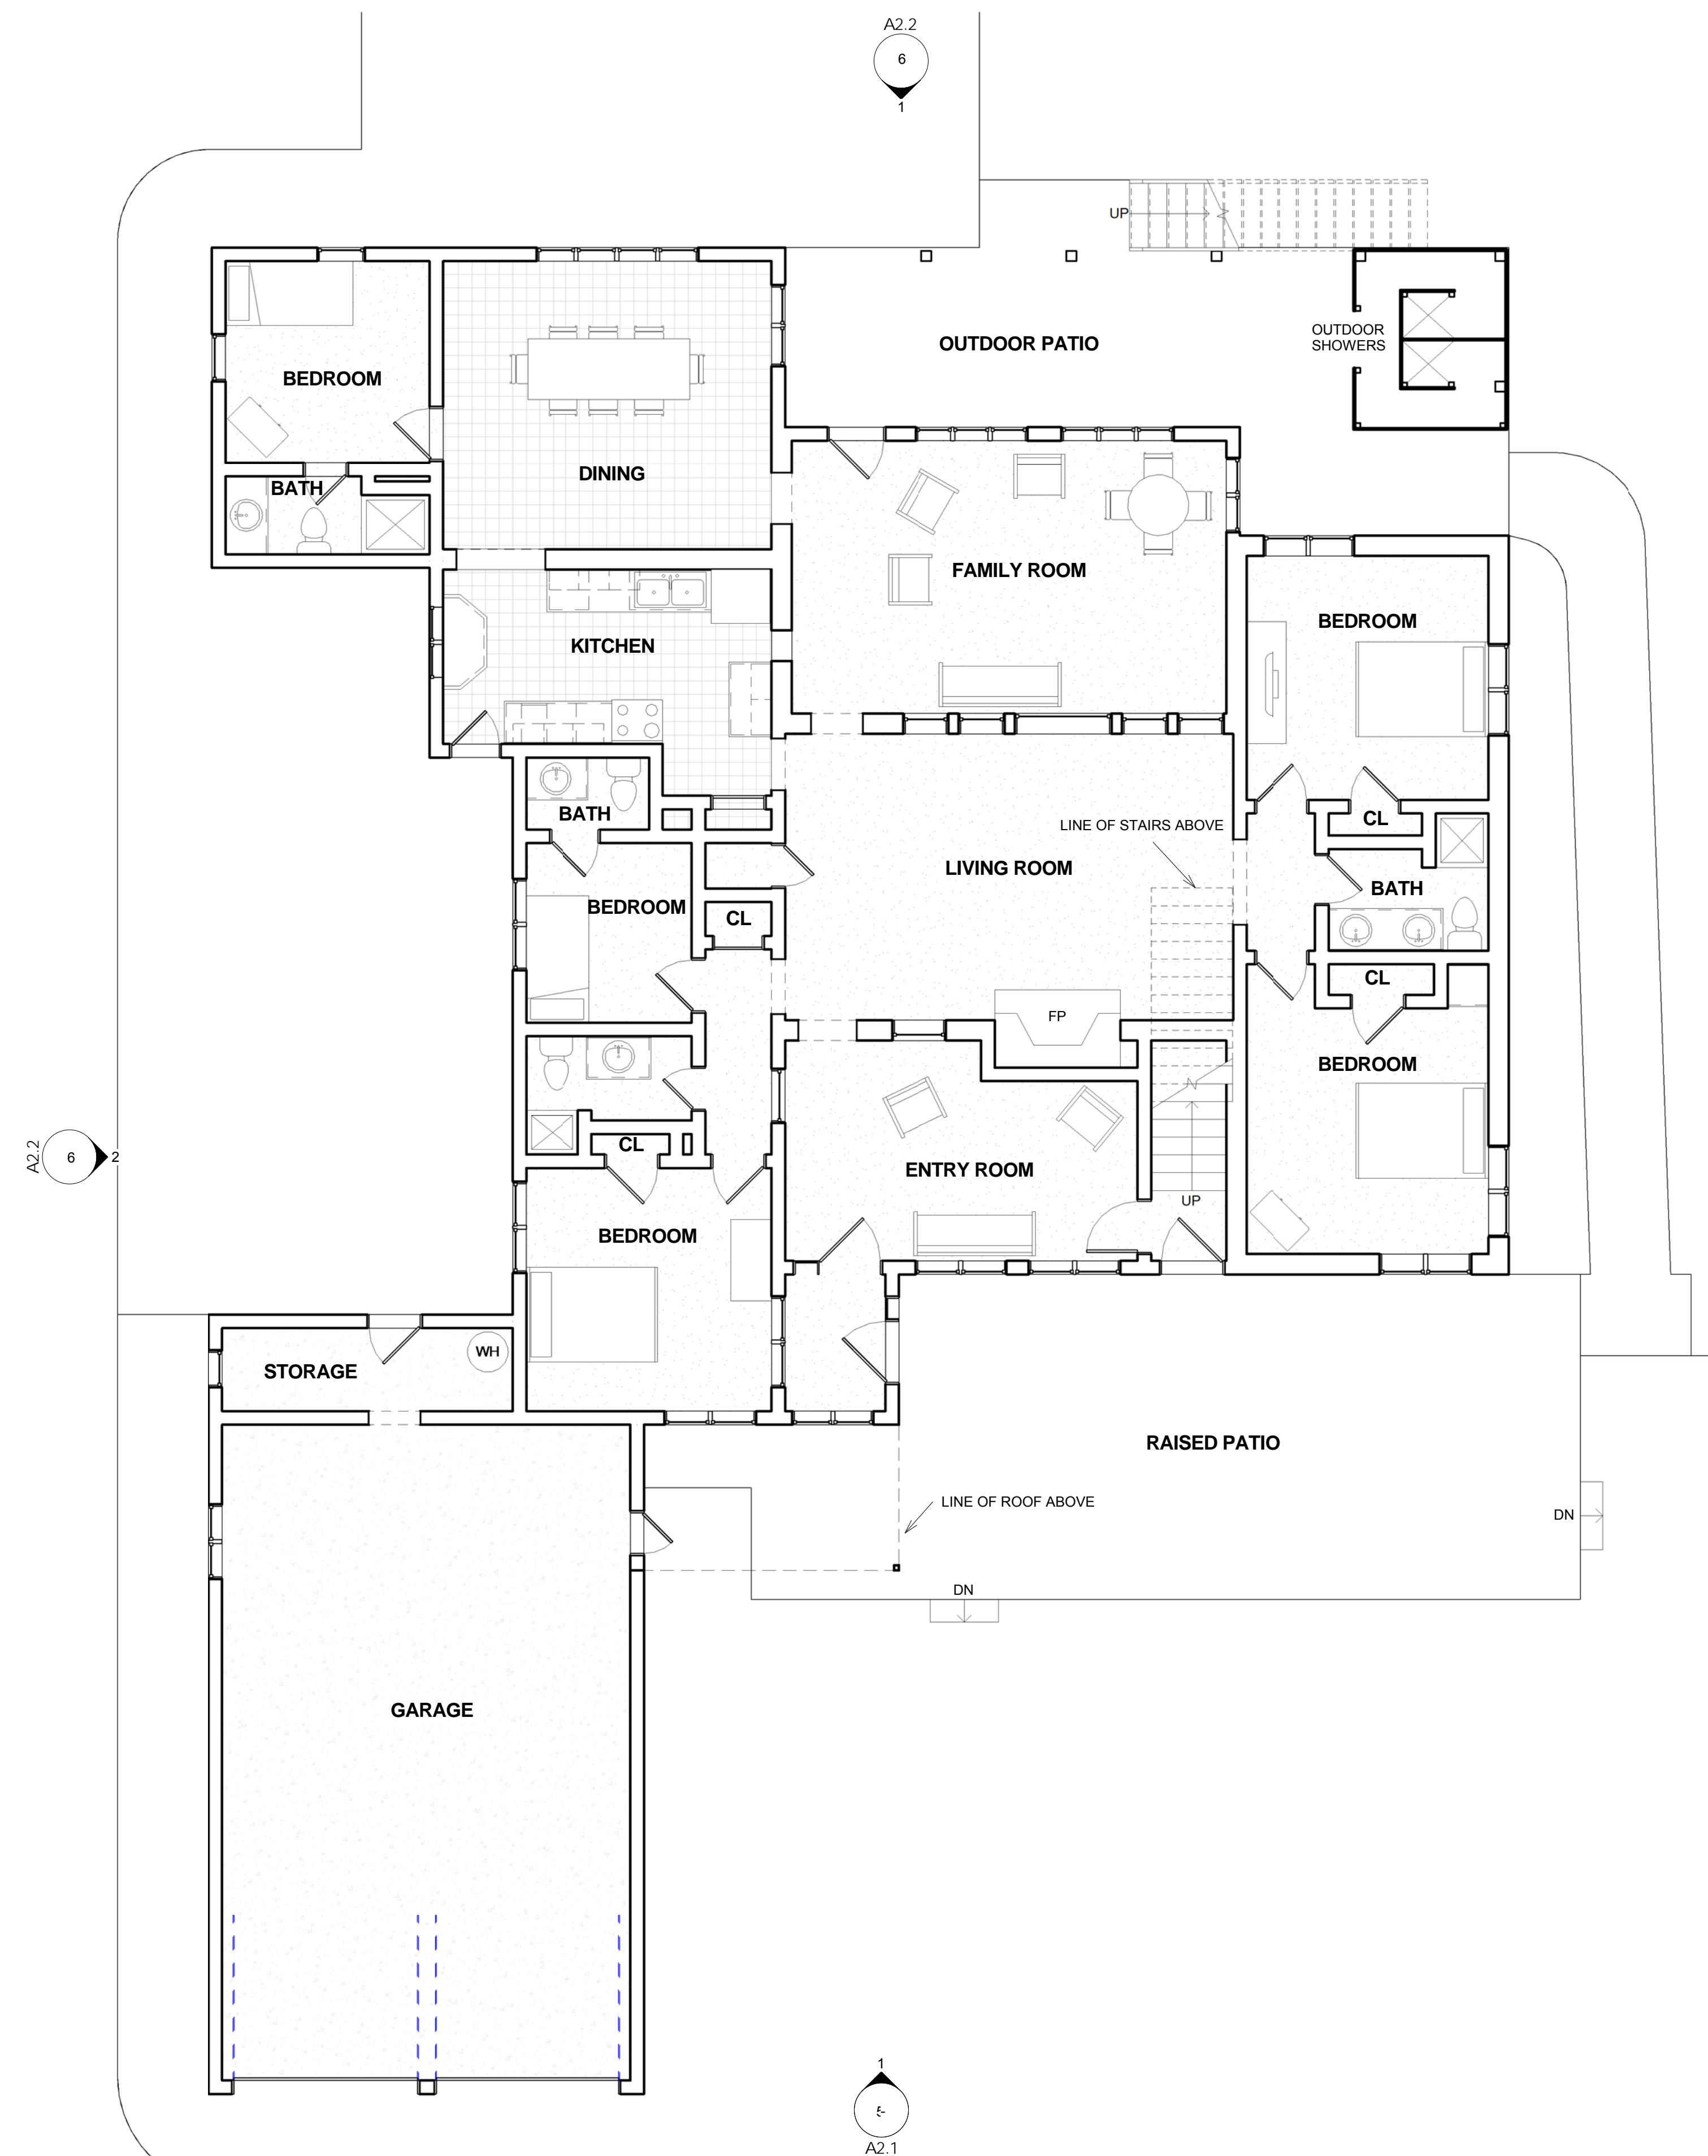

1 FIRST FLOOR PLAN  
 3/16" = 1'-0"

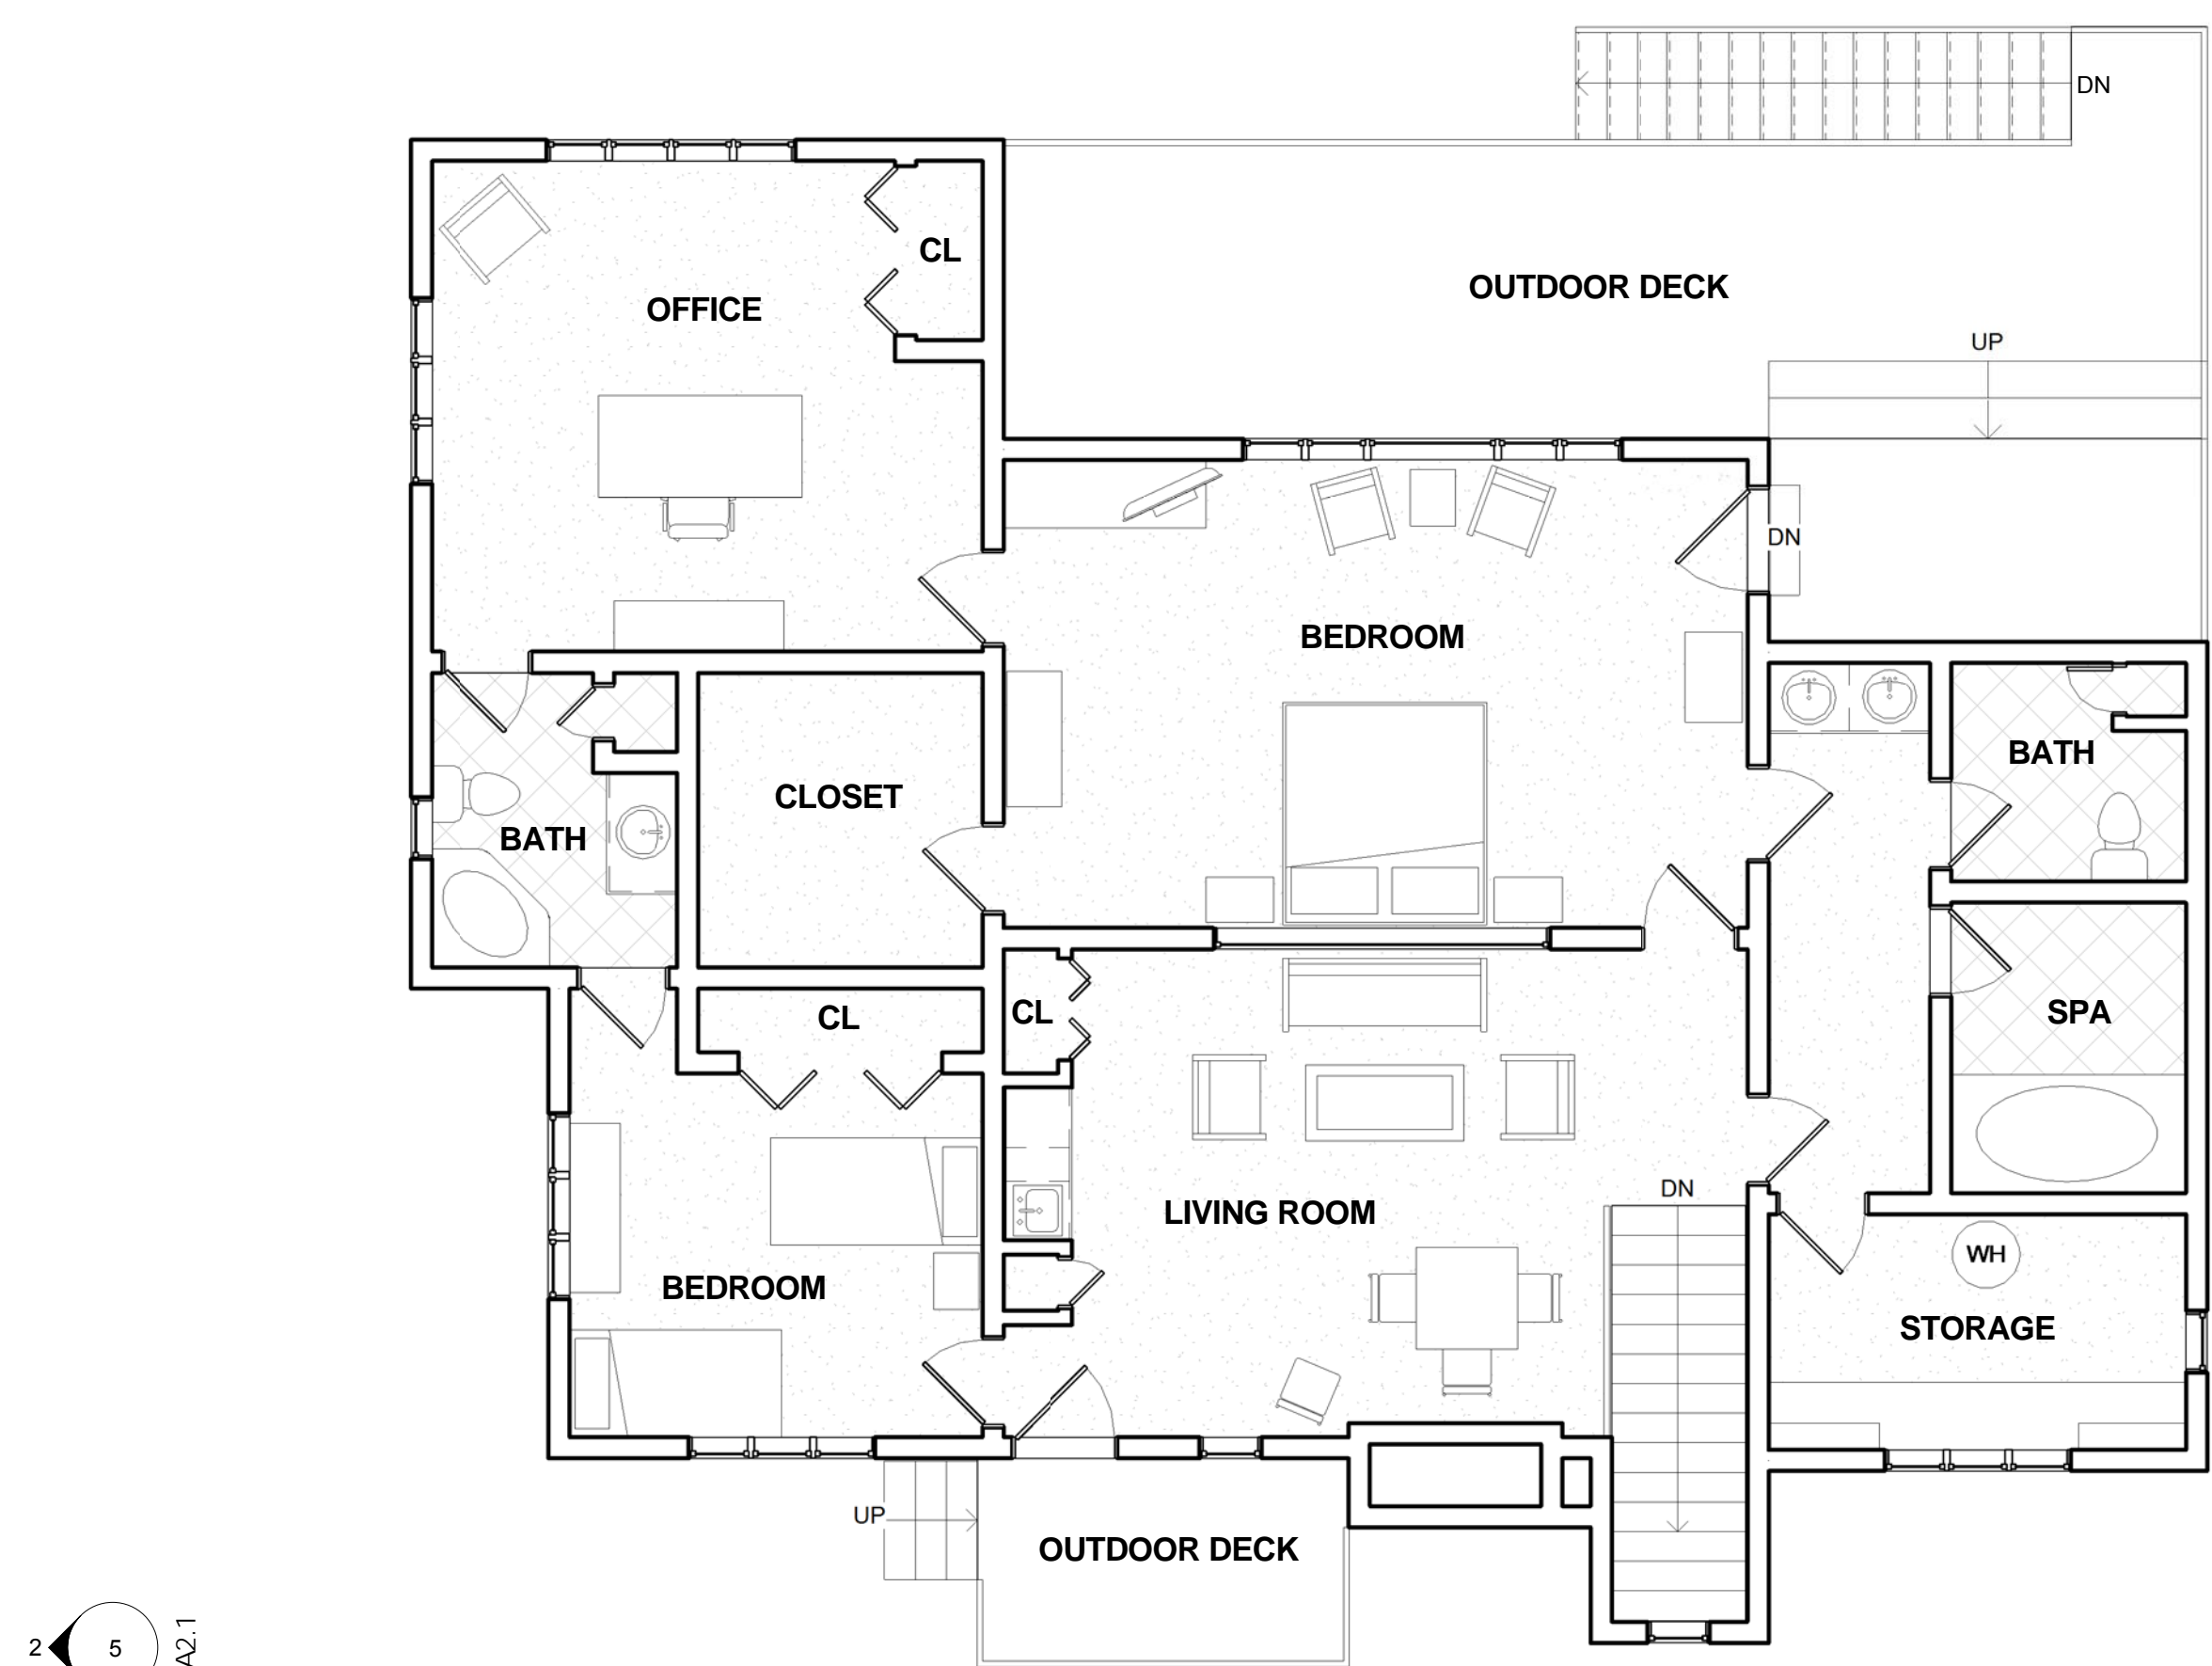

2 SECOND FLOOR PLAN  
 3/16" = 1'-0"



3 EAST PERSPECTIVE

PROJECT NAME:  
**PERKINSON'S COTTAGE**  
 142 OCEAN BLVD  
 SOUTHERN SHORES  
 NORTH CAROLINA

REVISIONS:	DATE:
AS- BUILTS	9/11/17

DRAWING NAME:  
**ROOF PLAN**

PRELIMINARY DRAWINGS  
 NOT FOR  
 CONSTRUCTION:

DRAWN BY: JT



DATE: 9/11/17

SCALE: SEE PLANS

STAMP:

© 2017 BEACON ARCHITECTURE + DESIGN P.L.L.C. - ALL RIGHTS RESERVED

SHEET:  
**A1.2**

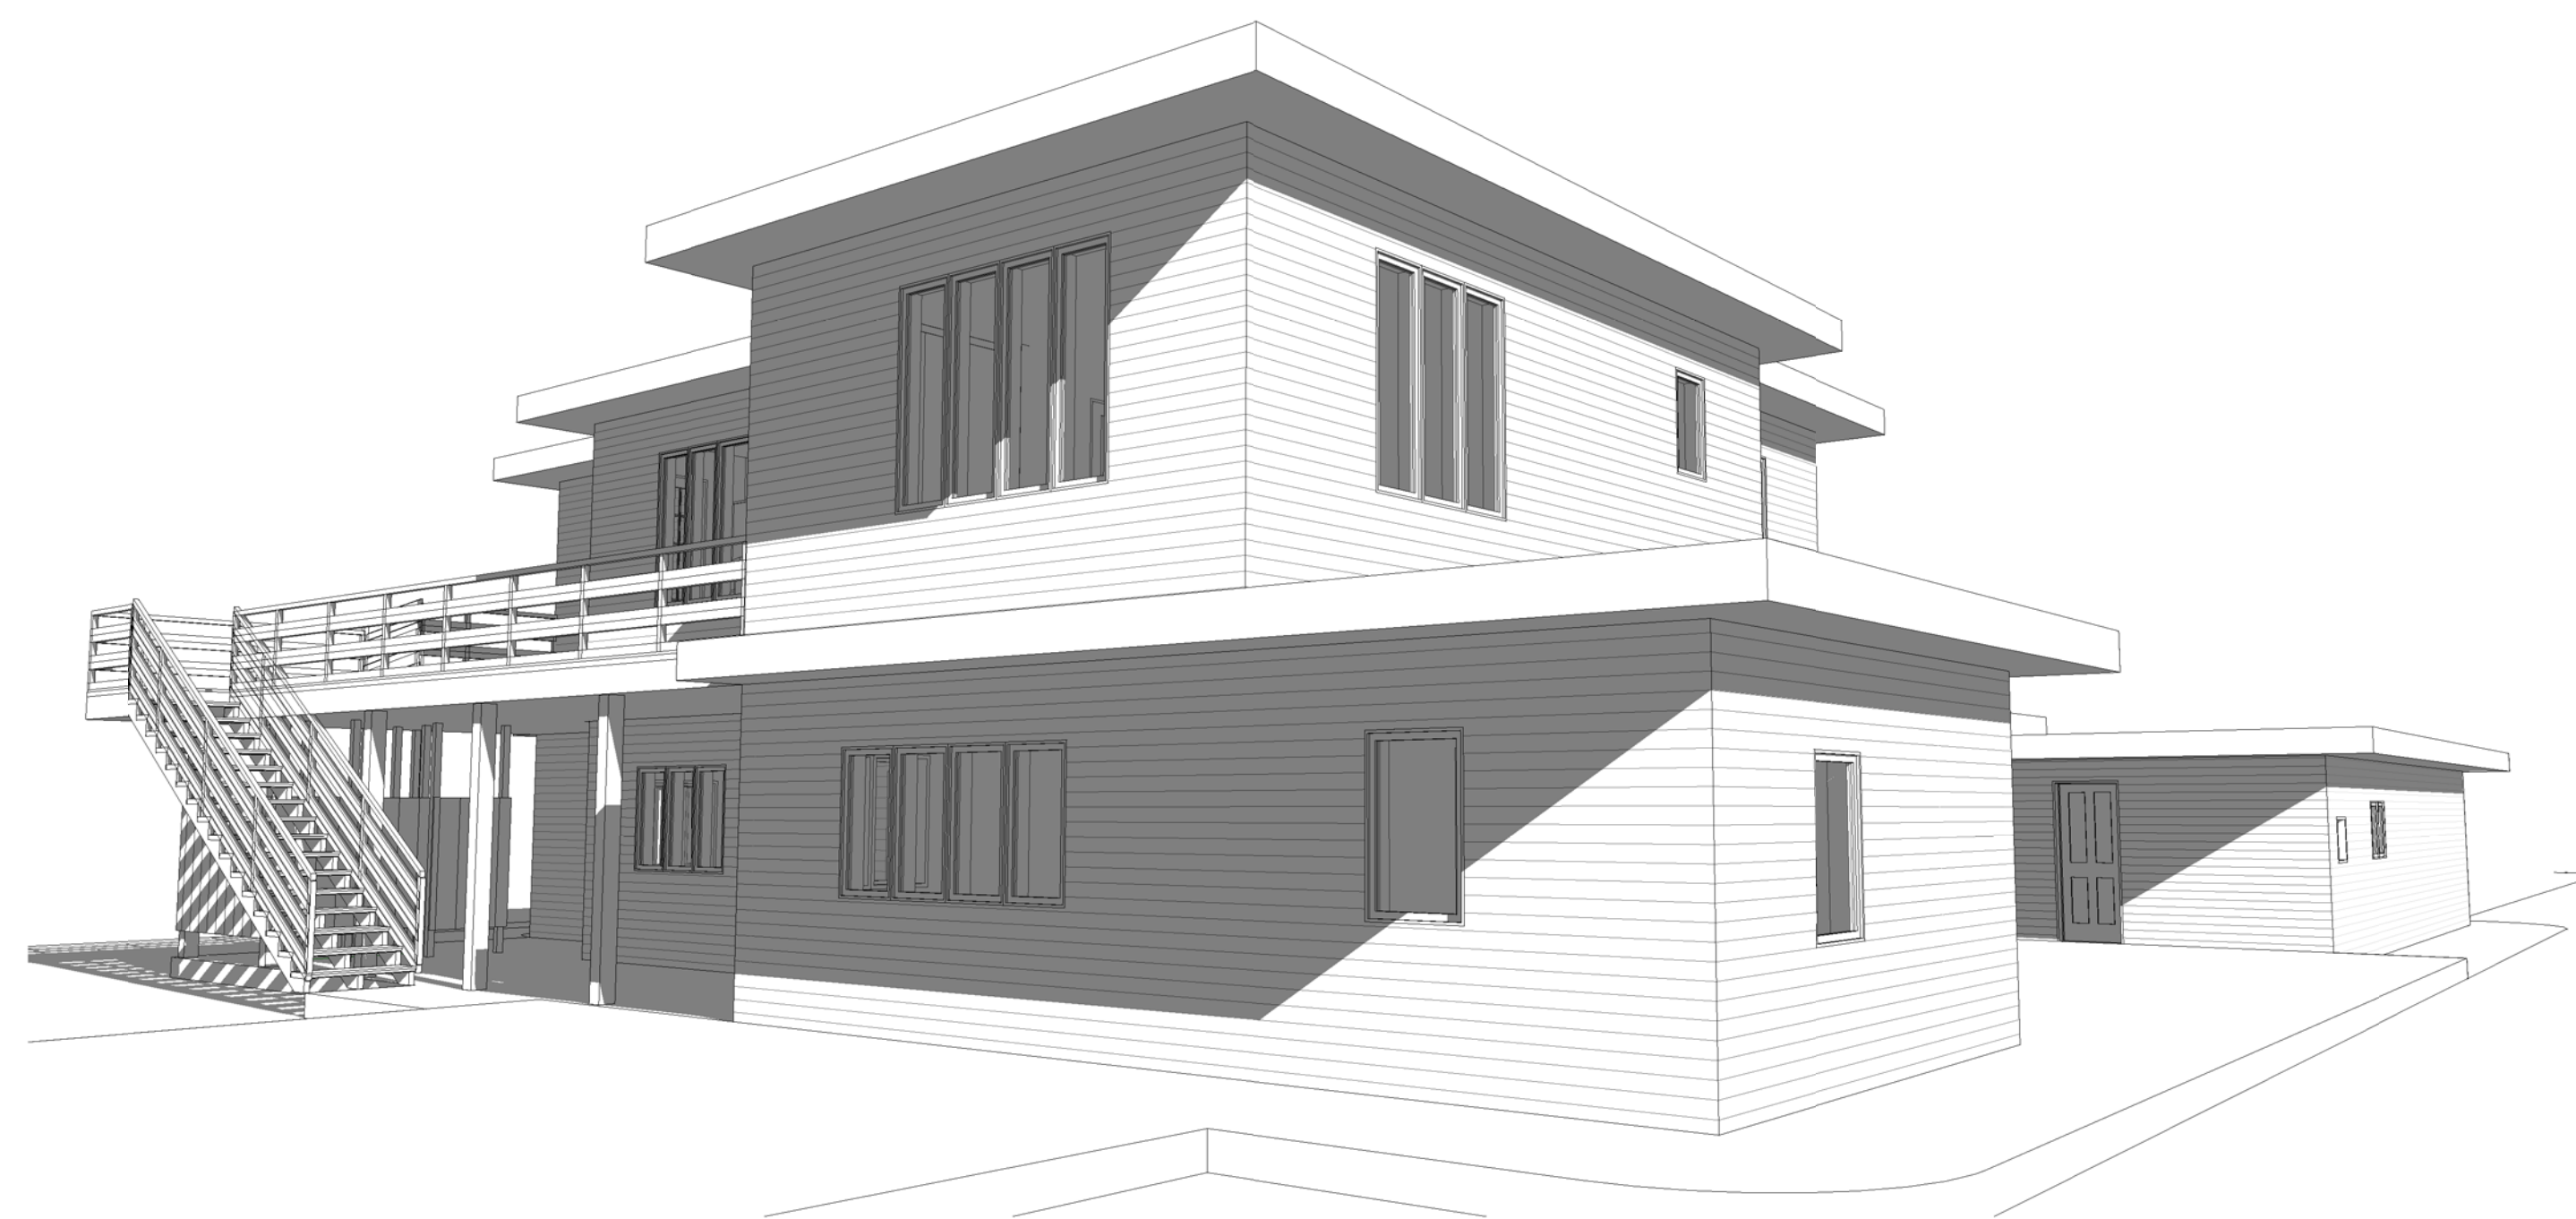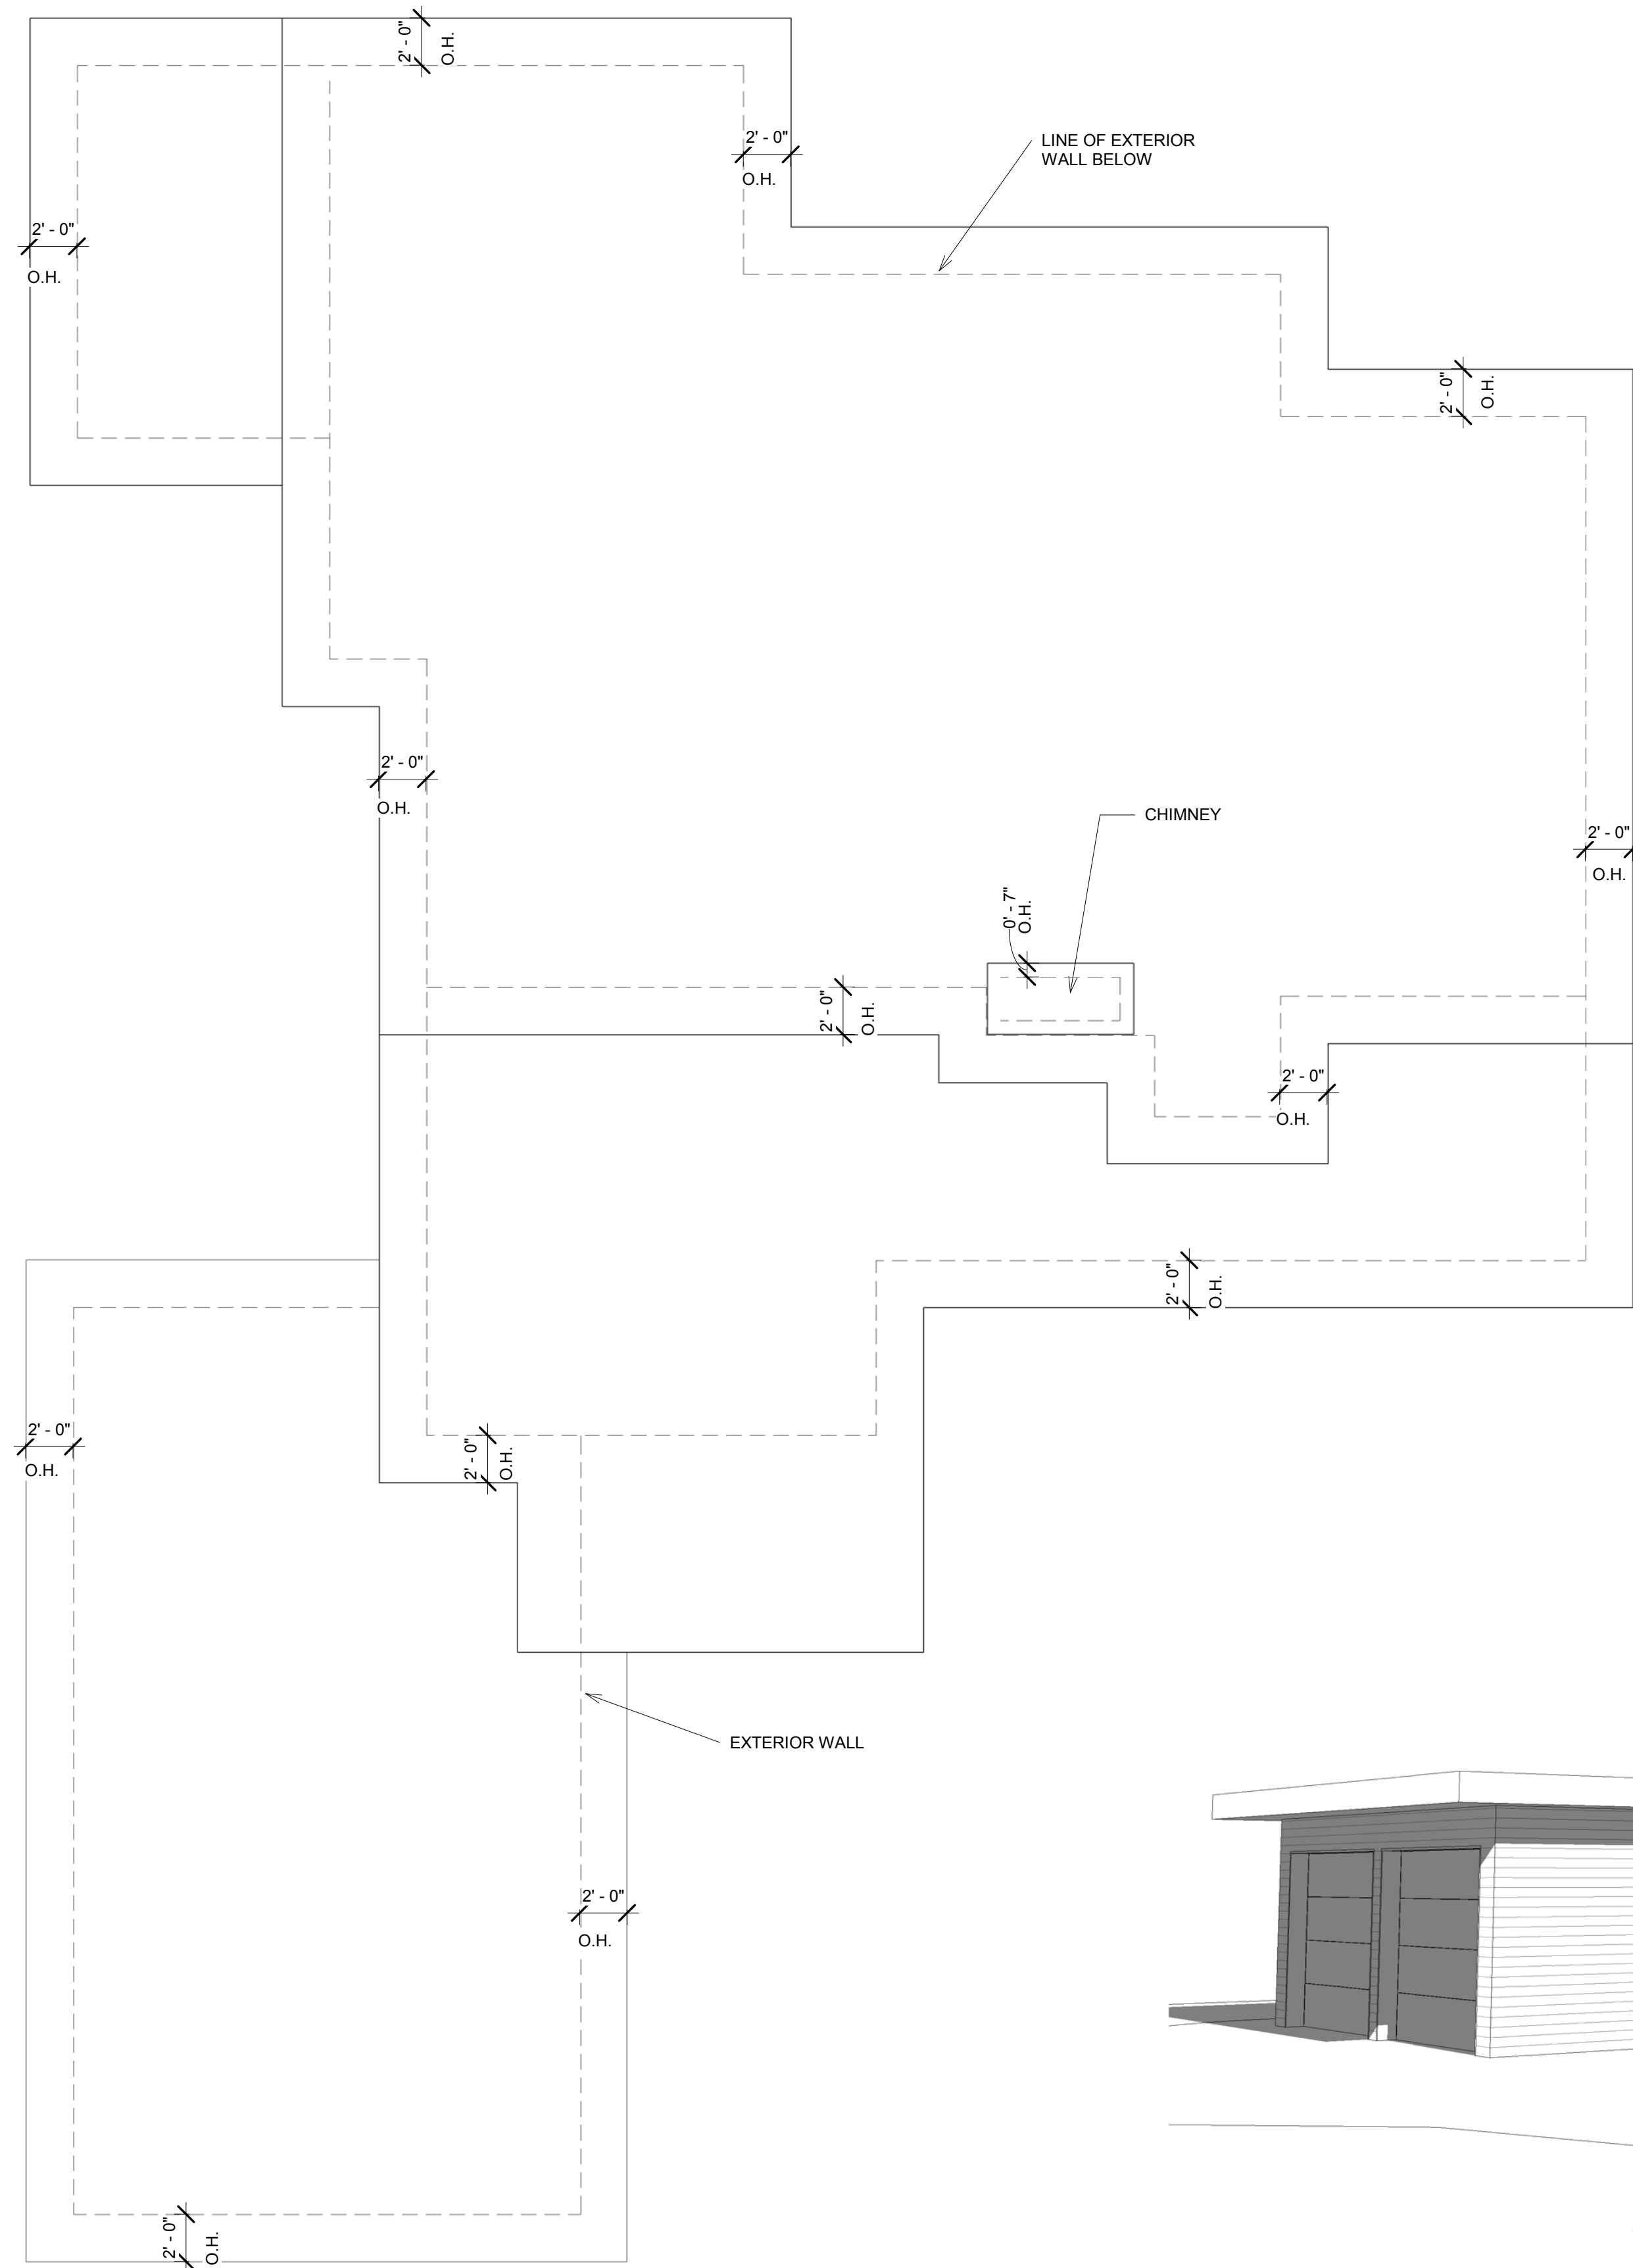

3 NORTHEAST PERSPECTIVE



2 SOUTHWEST PERSPECTIVE

1 ROOF PLAN  
 3/16" = 1'-0"

PROJECT NAME:  
**PERKINSON'S COTTAGE**  
 142 OCEAN BLVD  
 SOUTHERN SHORES  
 NORTH CAROLINA

REVISIONS:	DATE:
AS-BUILTS	9/11/17

DRAWING NAME:  
**ELEVATIONS WEST/SOUTH**

PRELIMINARY DRAWINGS  
 NOT FOR  
 CONSTRUCTION:

DRAWN BY: JT


DATE: 9/11/17

SCALE: SEE PLANS


STAMP:

© 2017 BEACON ARCHITECTURE + DESIGN P.L.L.C. - ALL RIGHTS RESERVED

SHEET:  
**A2.1**

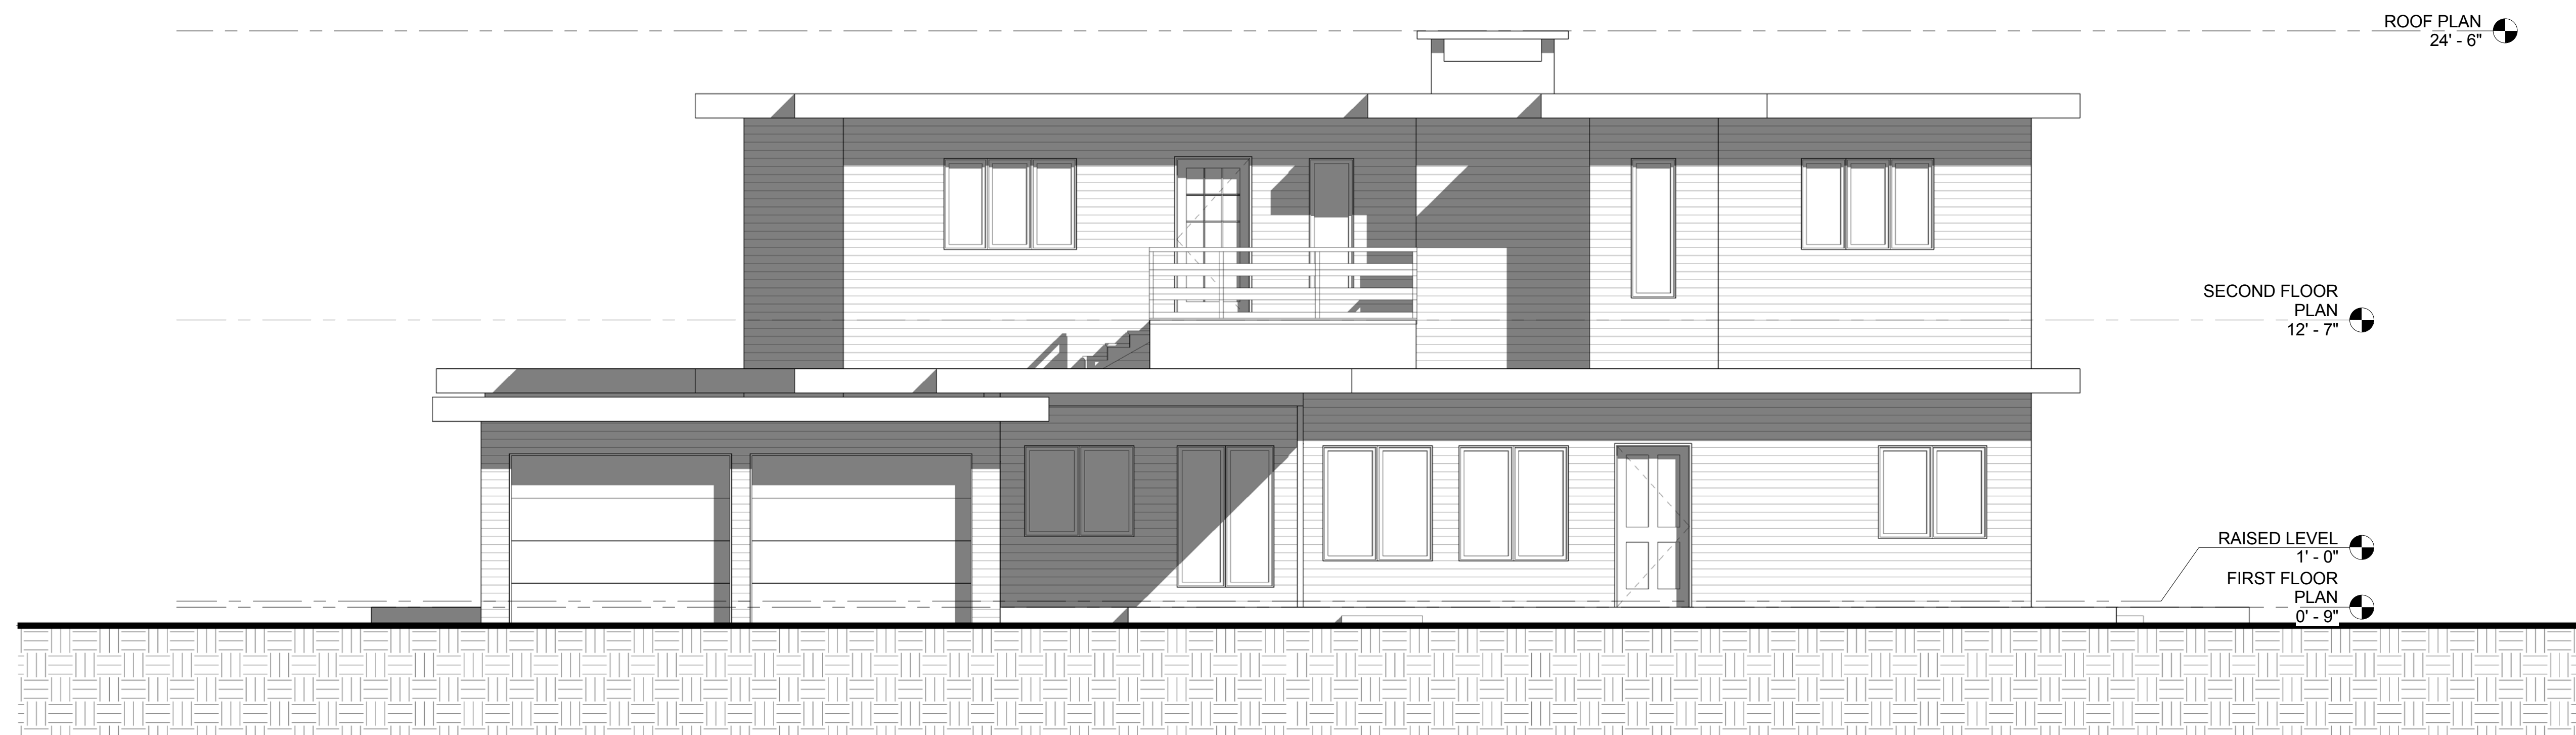

① WEST  
 1/4" = 1'-0"

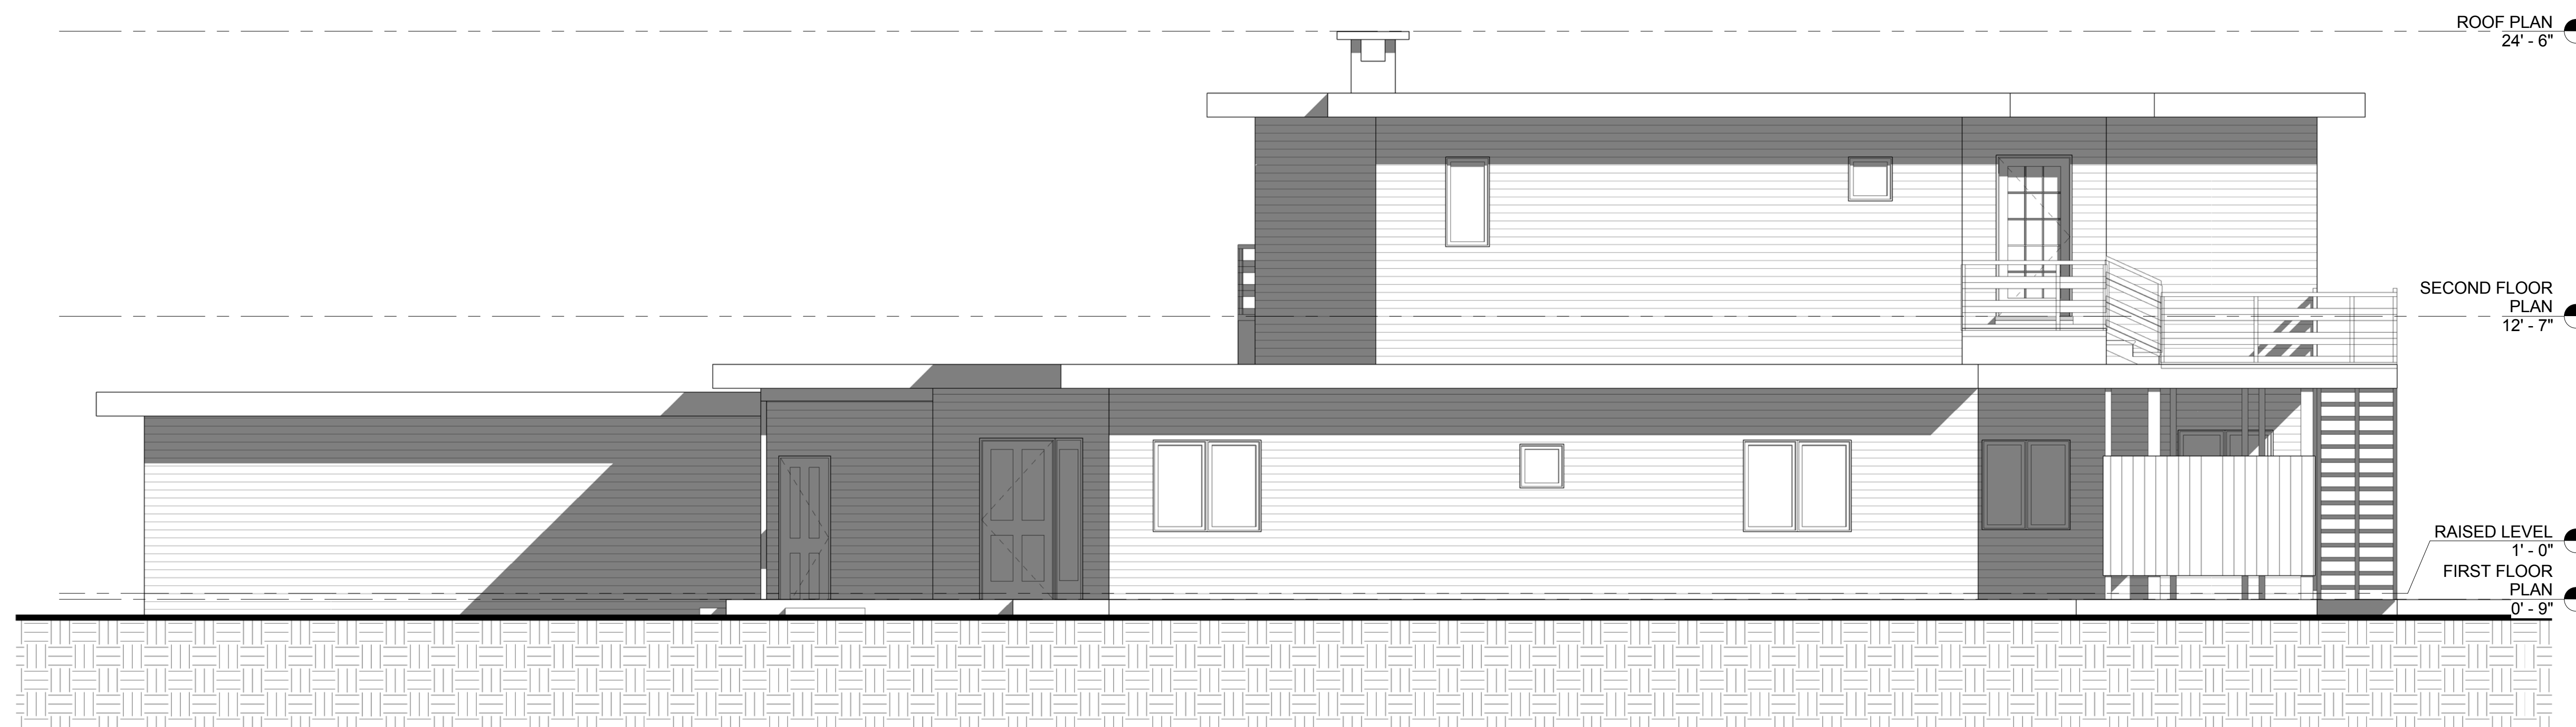

② SOUTH  
 1/4" = 1'-0"

PROJECT NAME:  
**PERKINSON'S  
 COTTAGE**  
 142 OCEAN BLVD  
 SOUTHERN SHORES  
 NORTH CAROLINA

REVISIONS:	DATE:
AS- BUILTS	9/11/17

DRAWING NAME:  
**ELEVATIONS  
 EAST/NORTH**

PRELIMINARY DRAWINGS  
 NOT FOR  
 CONSTRUCTION:

DRAWN BY: JT

DATE: 9/11/17

SCALE: SEE PLANS

STAMP:



① EAST  
 1/4" = 1'-0"



② NORTH  
 1/4" = 1'-0"