


① FRONT PERSPECTIVE

## LIST OF DRAWINGS

### ARCHITECTURAL DRAWINGS

- T1.1 TITLE SHEET
- A1.1 FIRST FLOOR
- A1.2 ROOF FRAMING PLAN & ROOF PLAN
- A2.1 ELEVATIONS

# 116 OCEAN BLVD SOUTHERN SHORES, NORTH CAROLINA

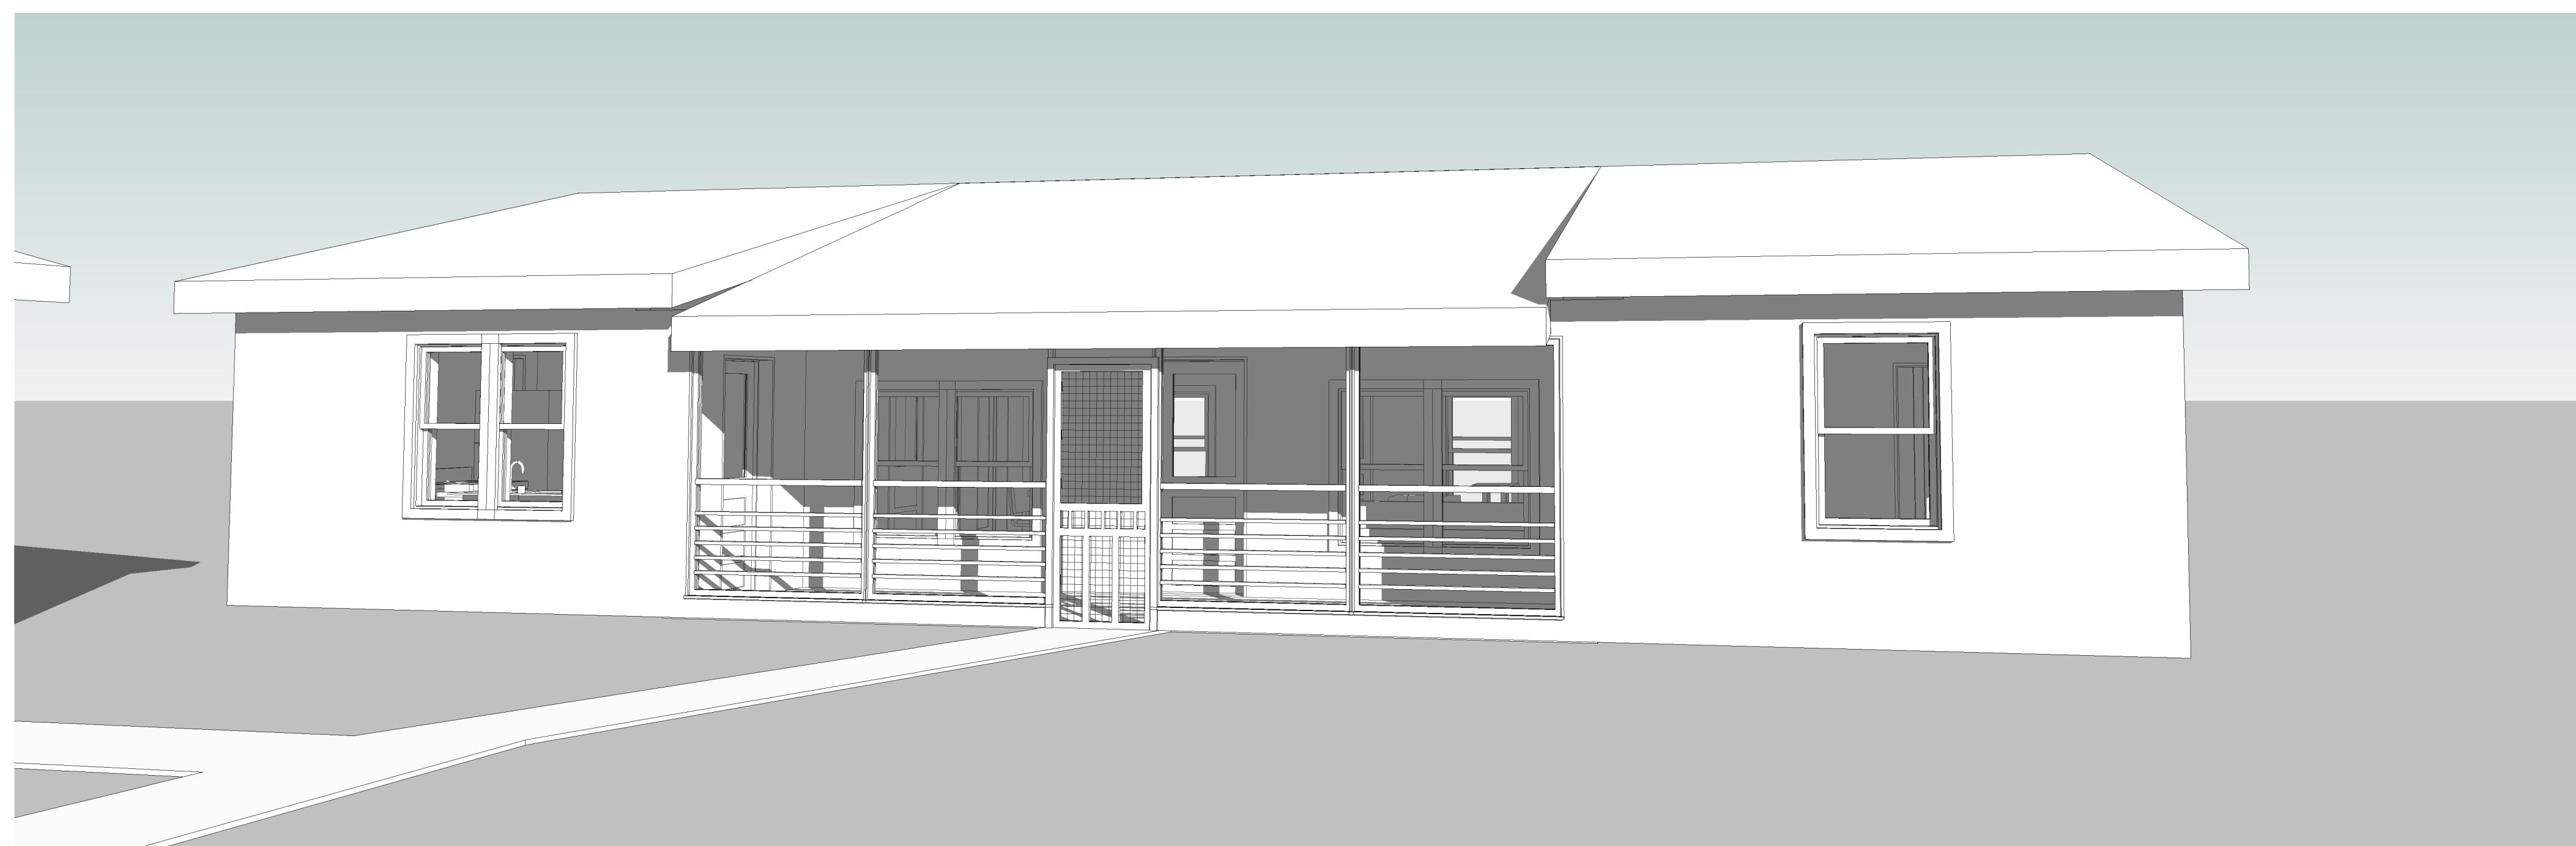

② FRONT PERSPECTIVE 2

PROJECT NAME:

116 OCEAN BLVD  
SOUTHERN SHORES  
NORTH CAROLINA

REVISIONS:	DATE:
AS-BUILTS	6 / 26 / 19

DRAWING NAME:

TITLE SHEET

PRELIMINARY DRAWINGS  
NOT FOR  
CONSTRUCTION:

DRAWN BY: DF



DATE: 6 / 26 / 19

SCALE: SEE PLANS

STAMP:

SHEET:

T1.1

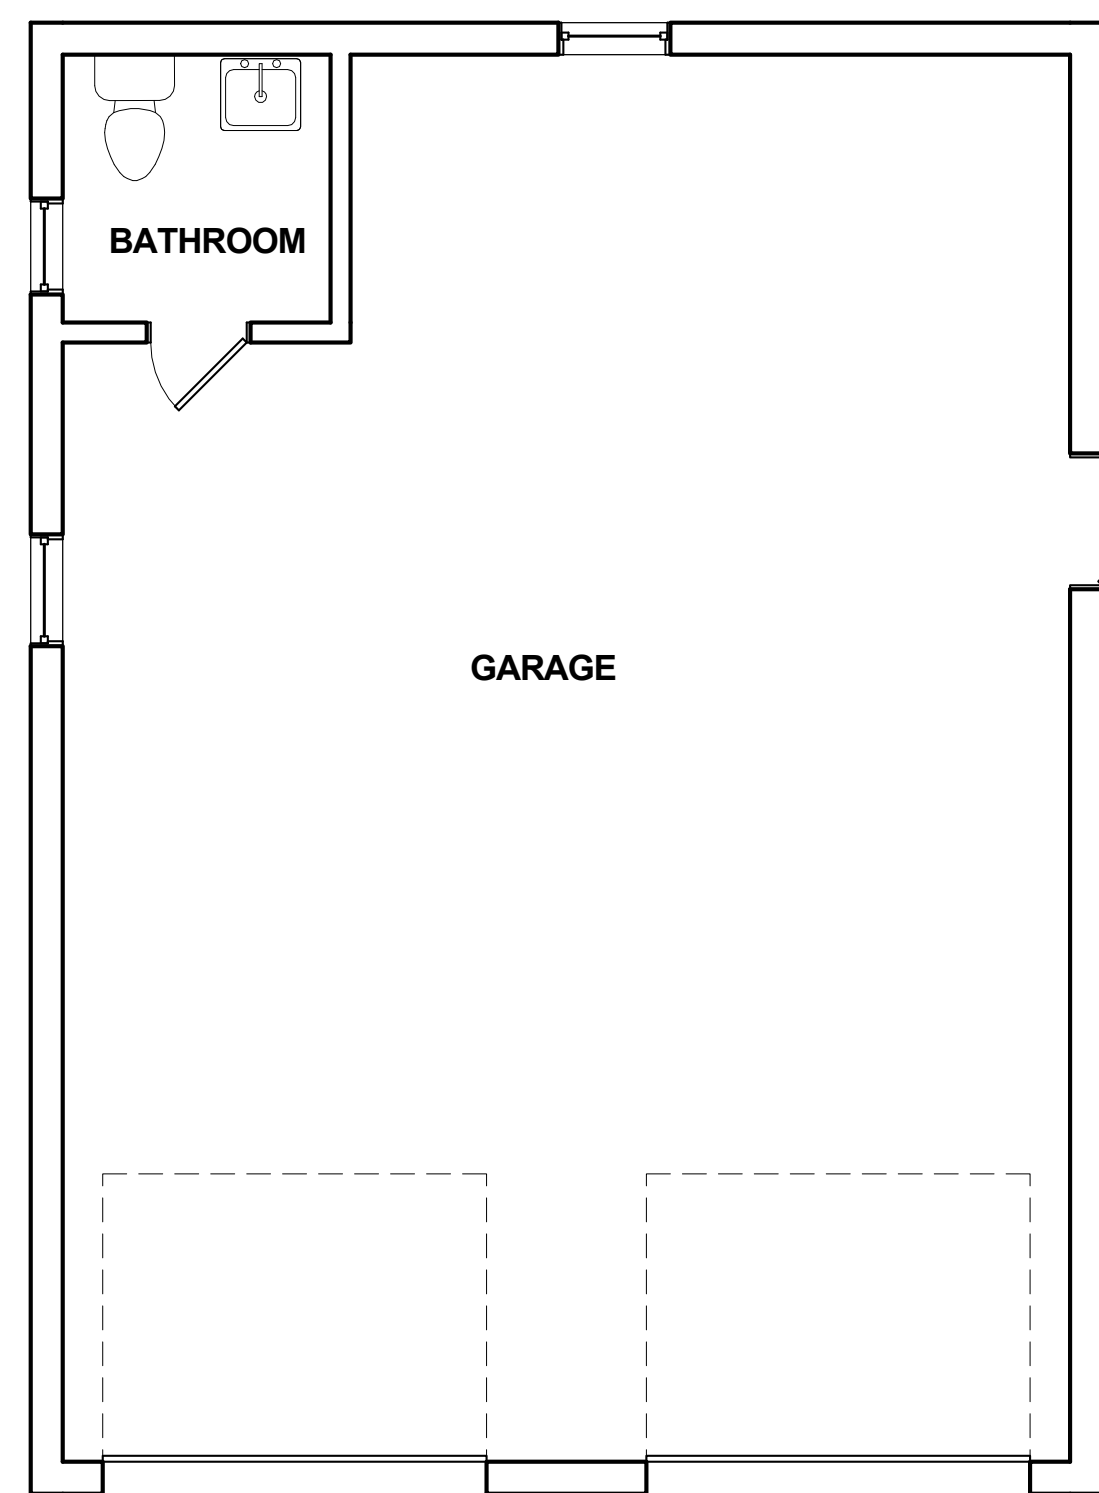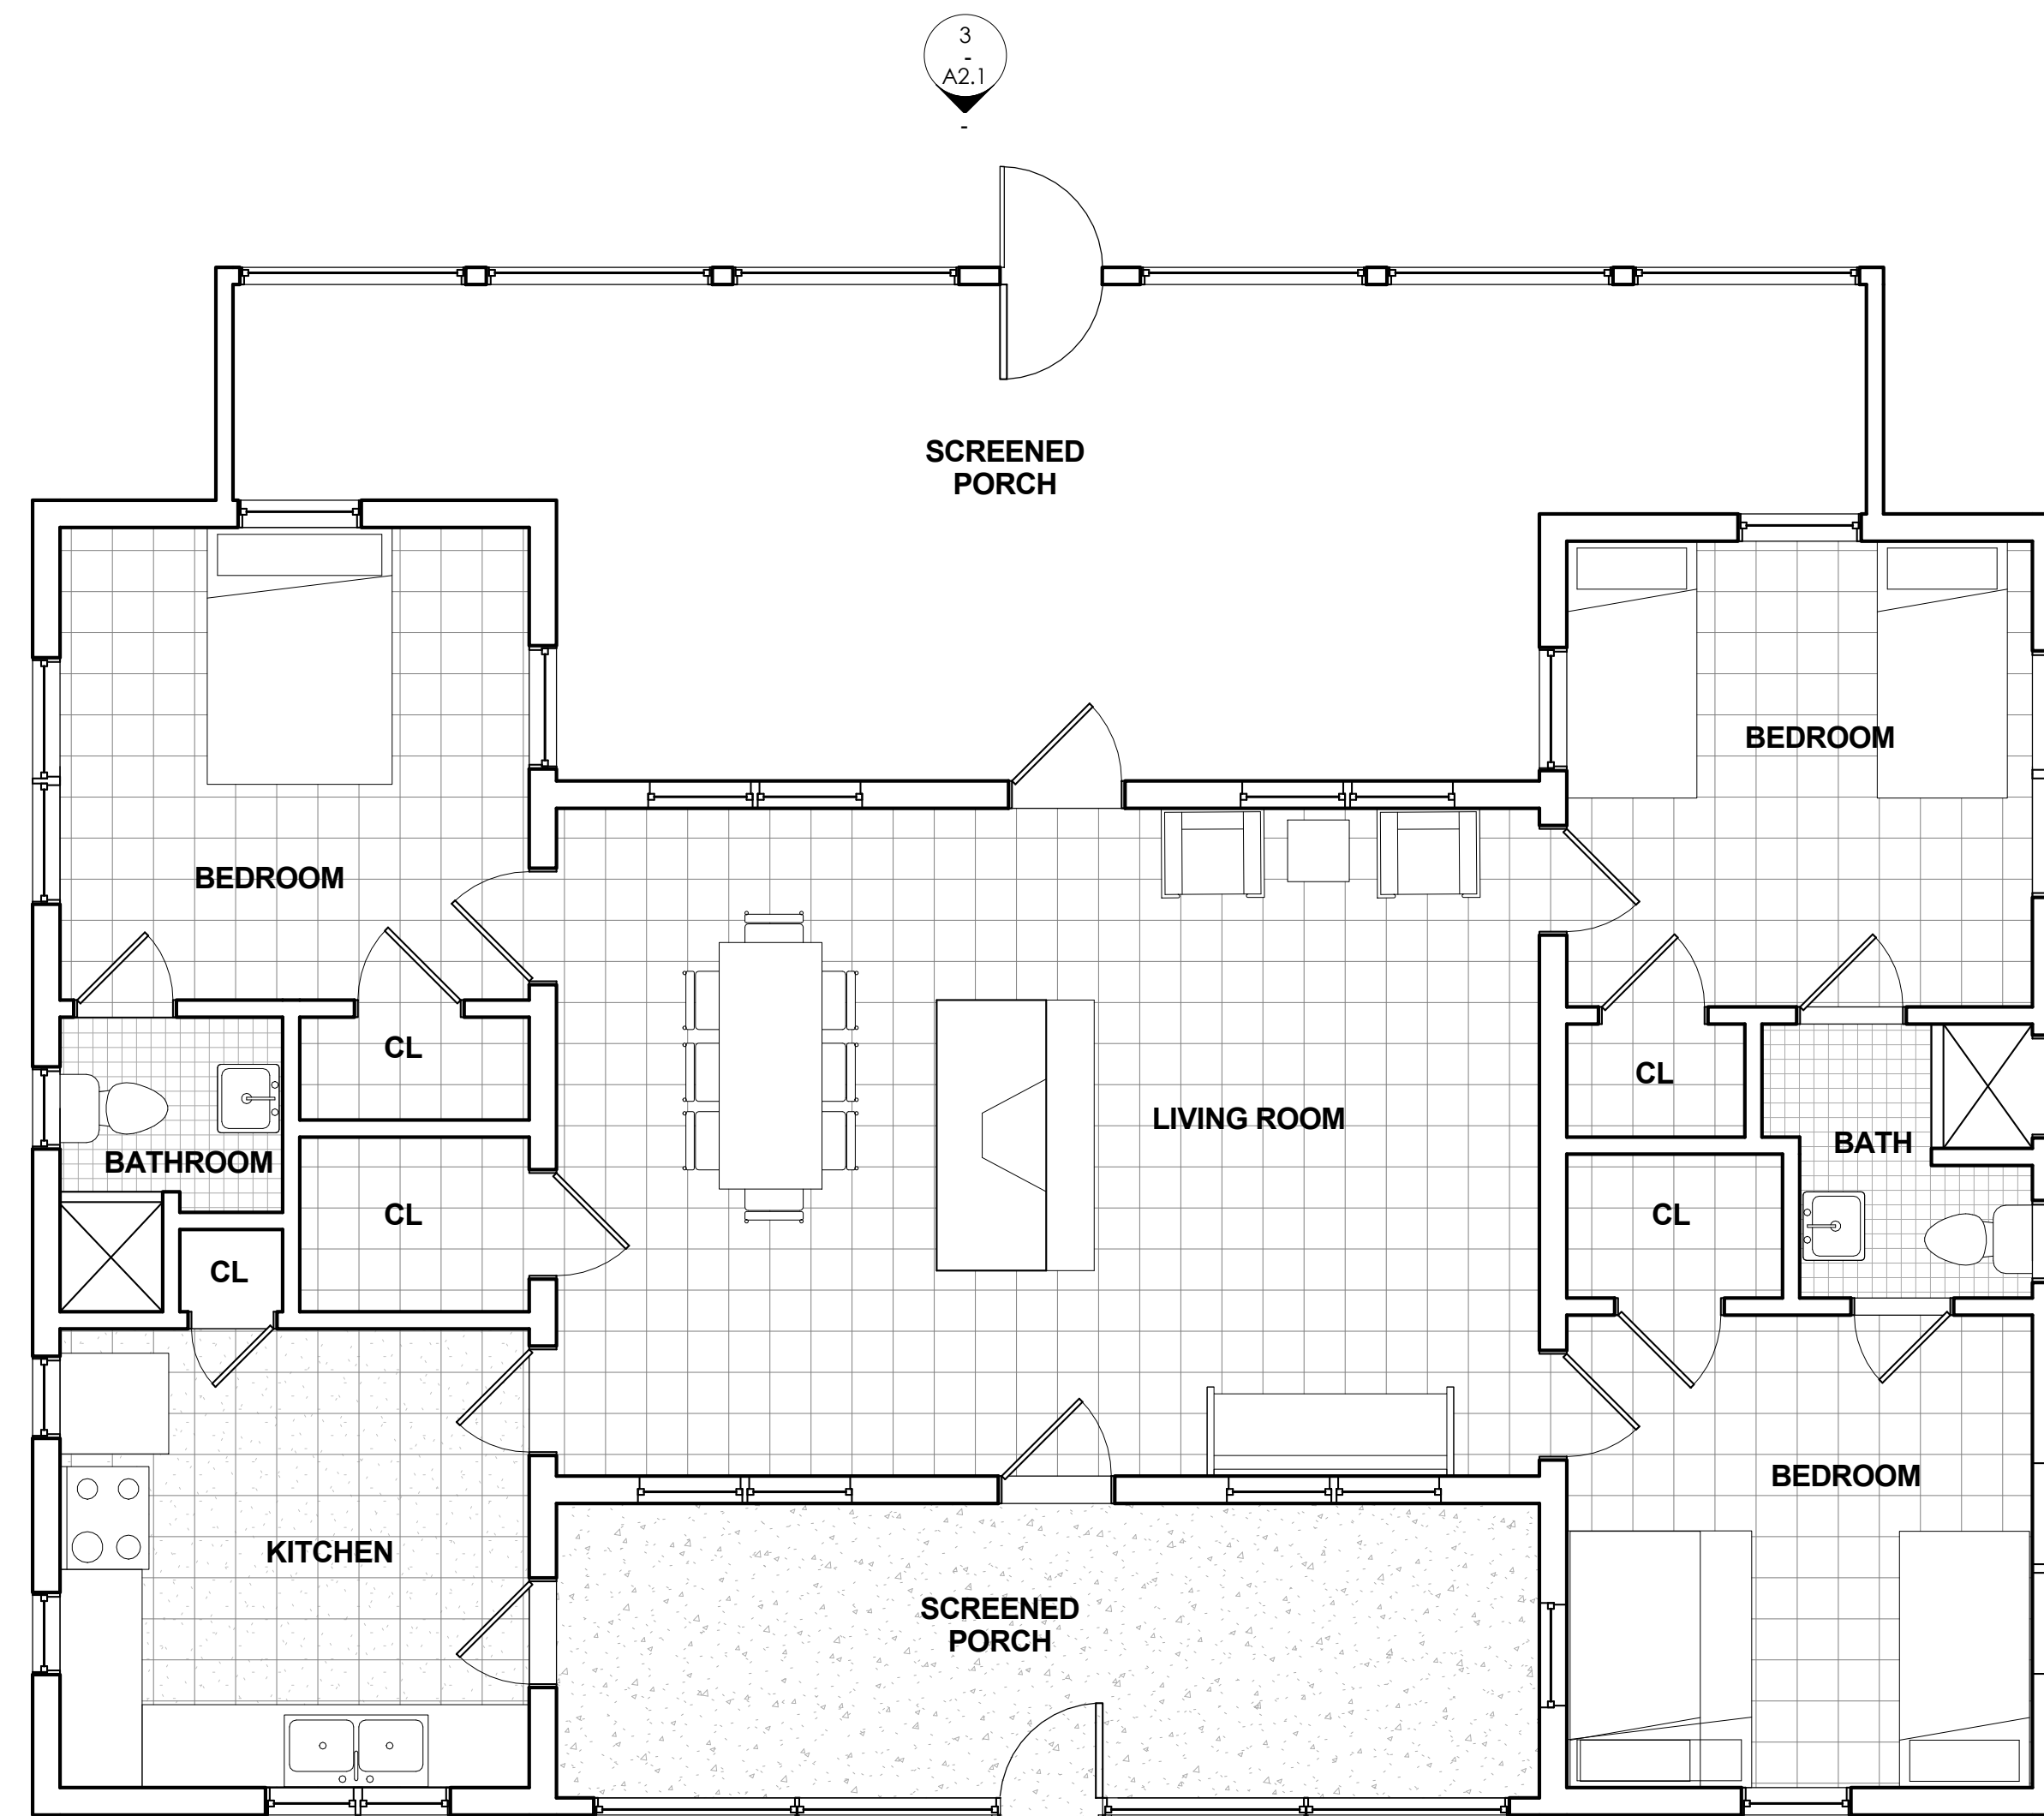

① FIRST FLOOR PLAN  
1/4" = 1'-0"

PROJECT NAME:  
  
116 OCEAN BLVD  
SOUTHERN SHORES  
NORTH CAROLINA

REVISIONS:	DATE:
AS-BUILTS	6 / 26 / 19

DRAWING NAME:  
  
FIRST FLOOR  
PLAN

PRELIMINARY DRAWINGS  
NOT FOR  
CONSTRUCTION:


DRAWN BY: DF

DATE: 6 / 26 / 19





SCALE: SEE PLANS

STAMP:

SHEET:  
  
A1.1

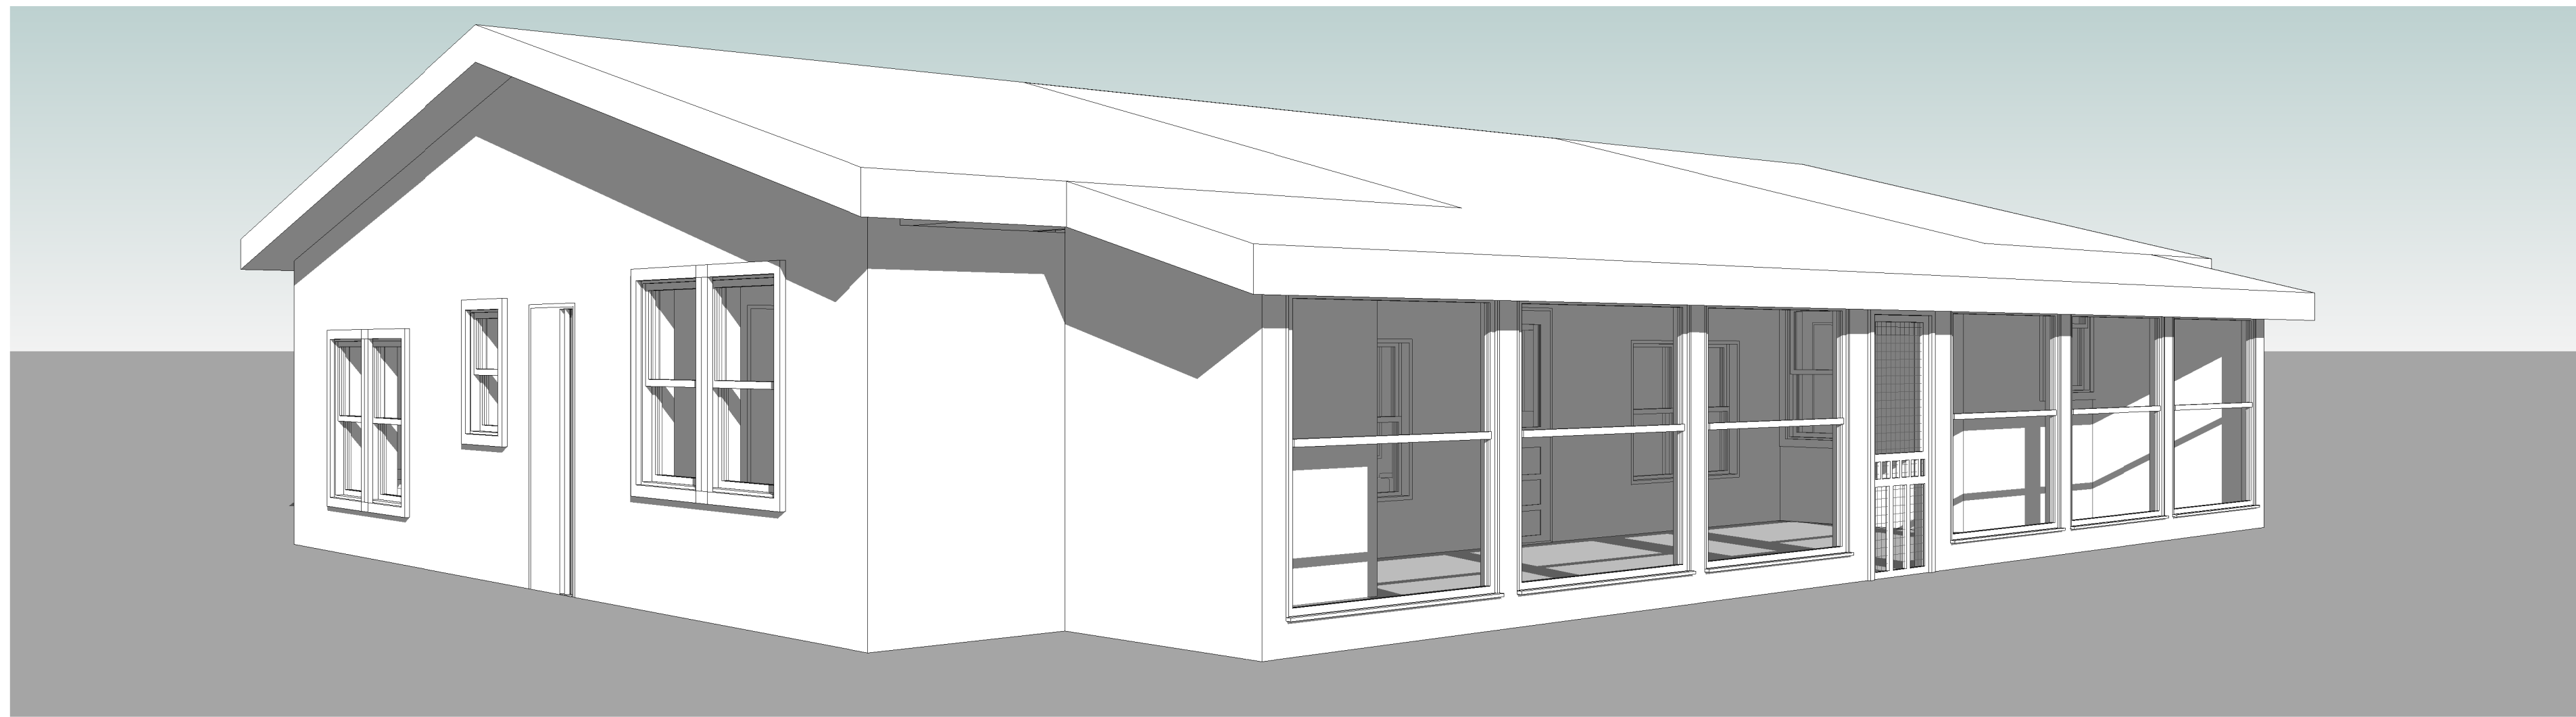

3 BACK PERSPECTIVE

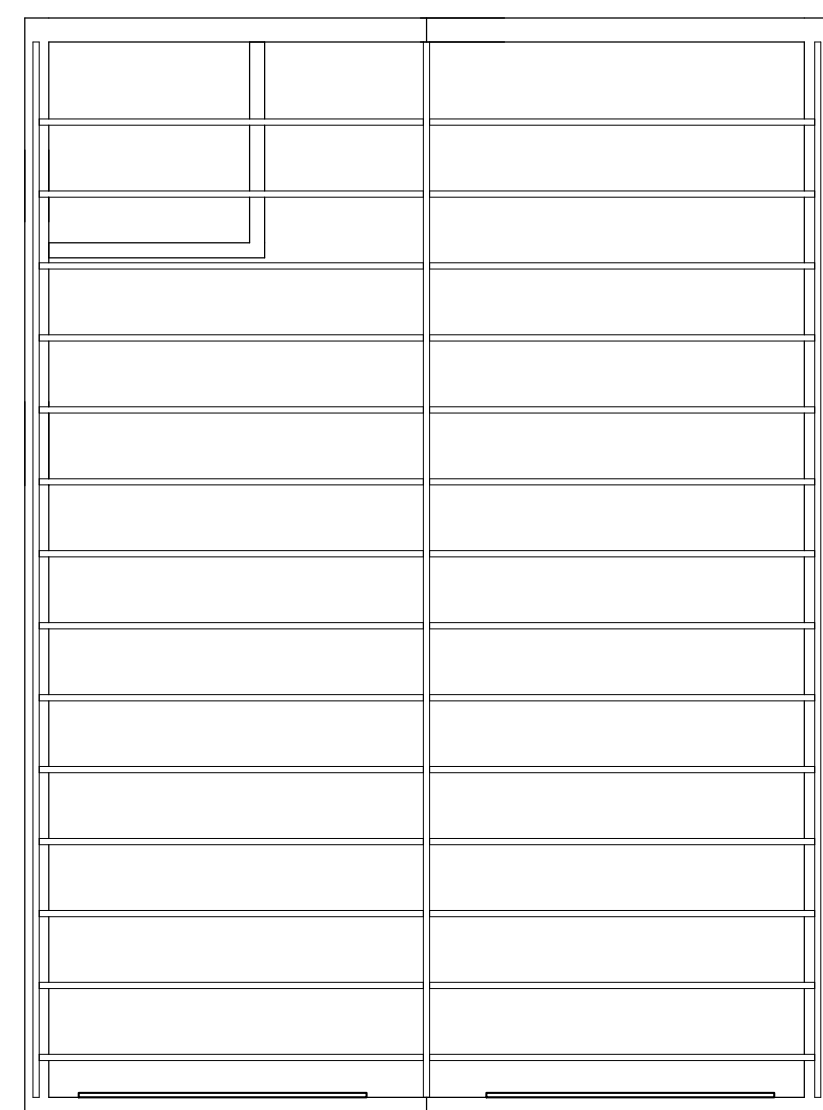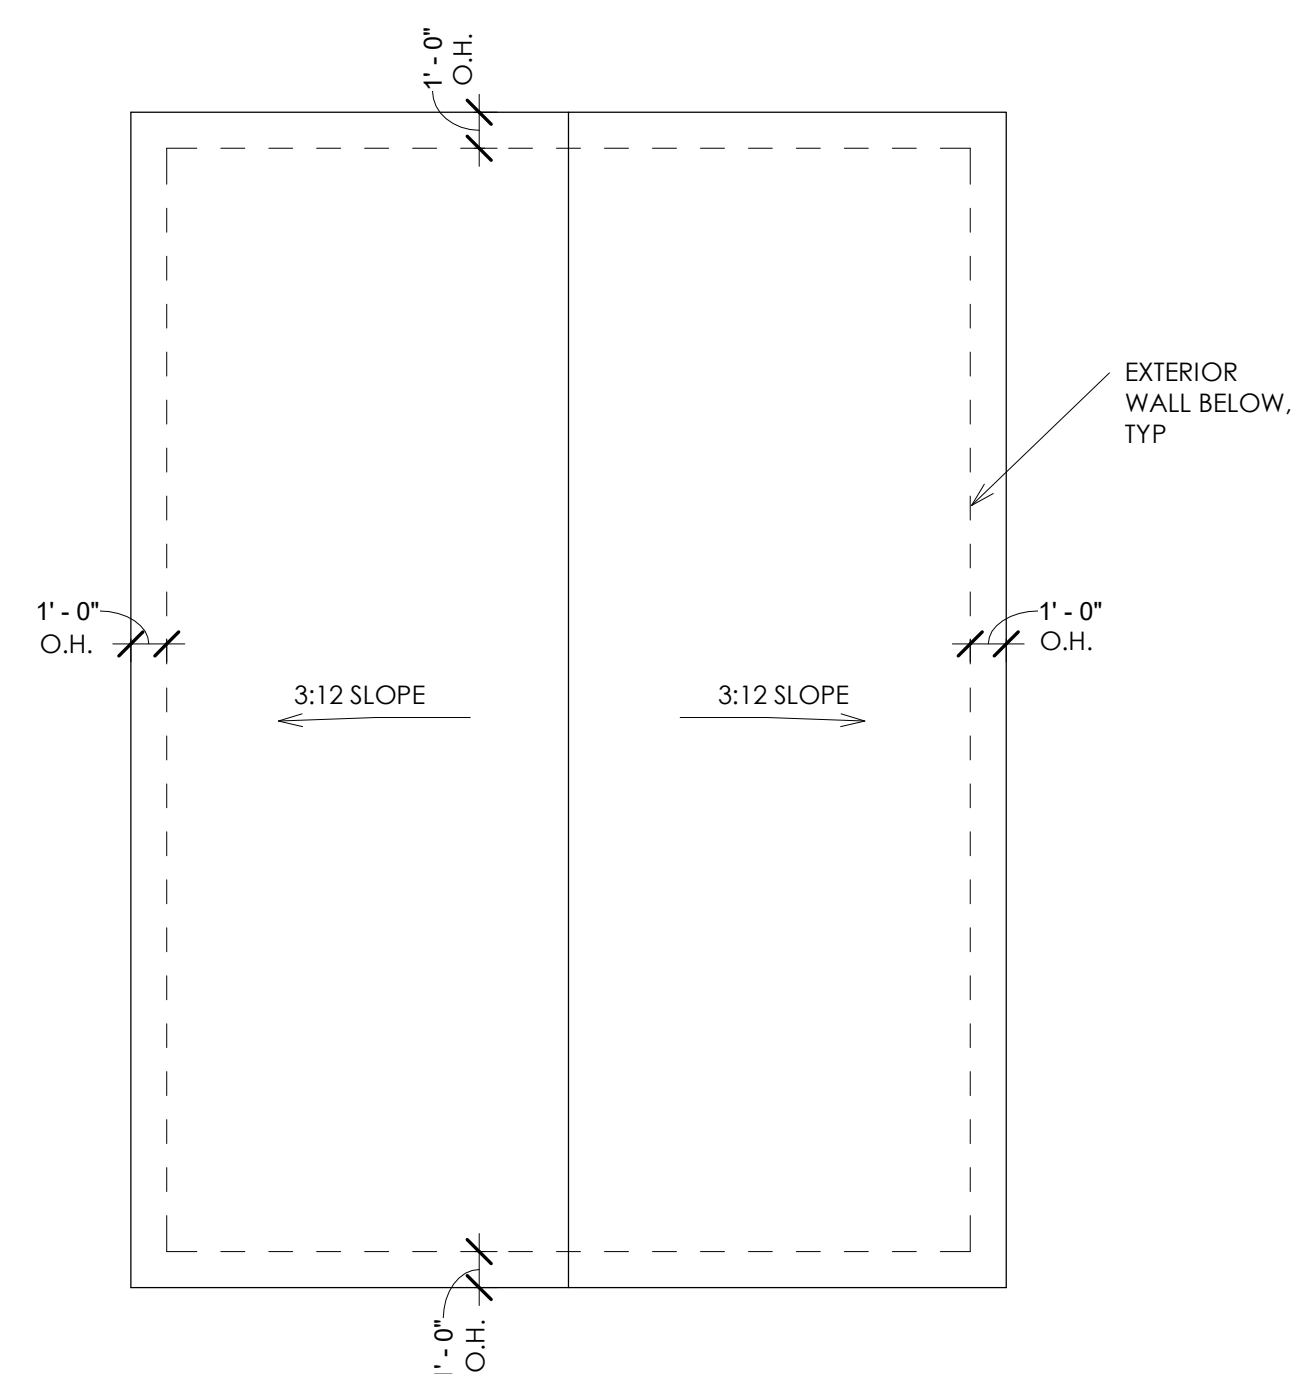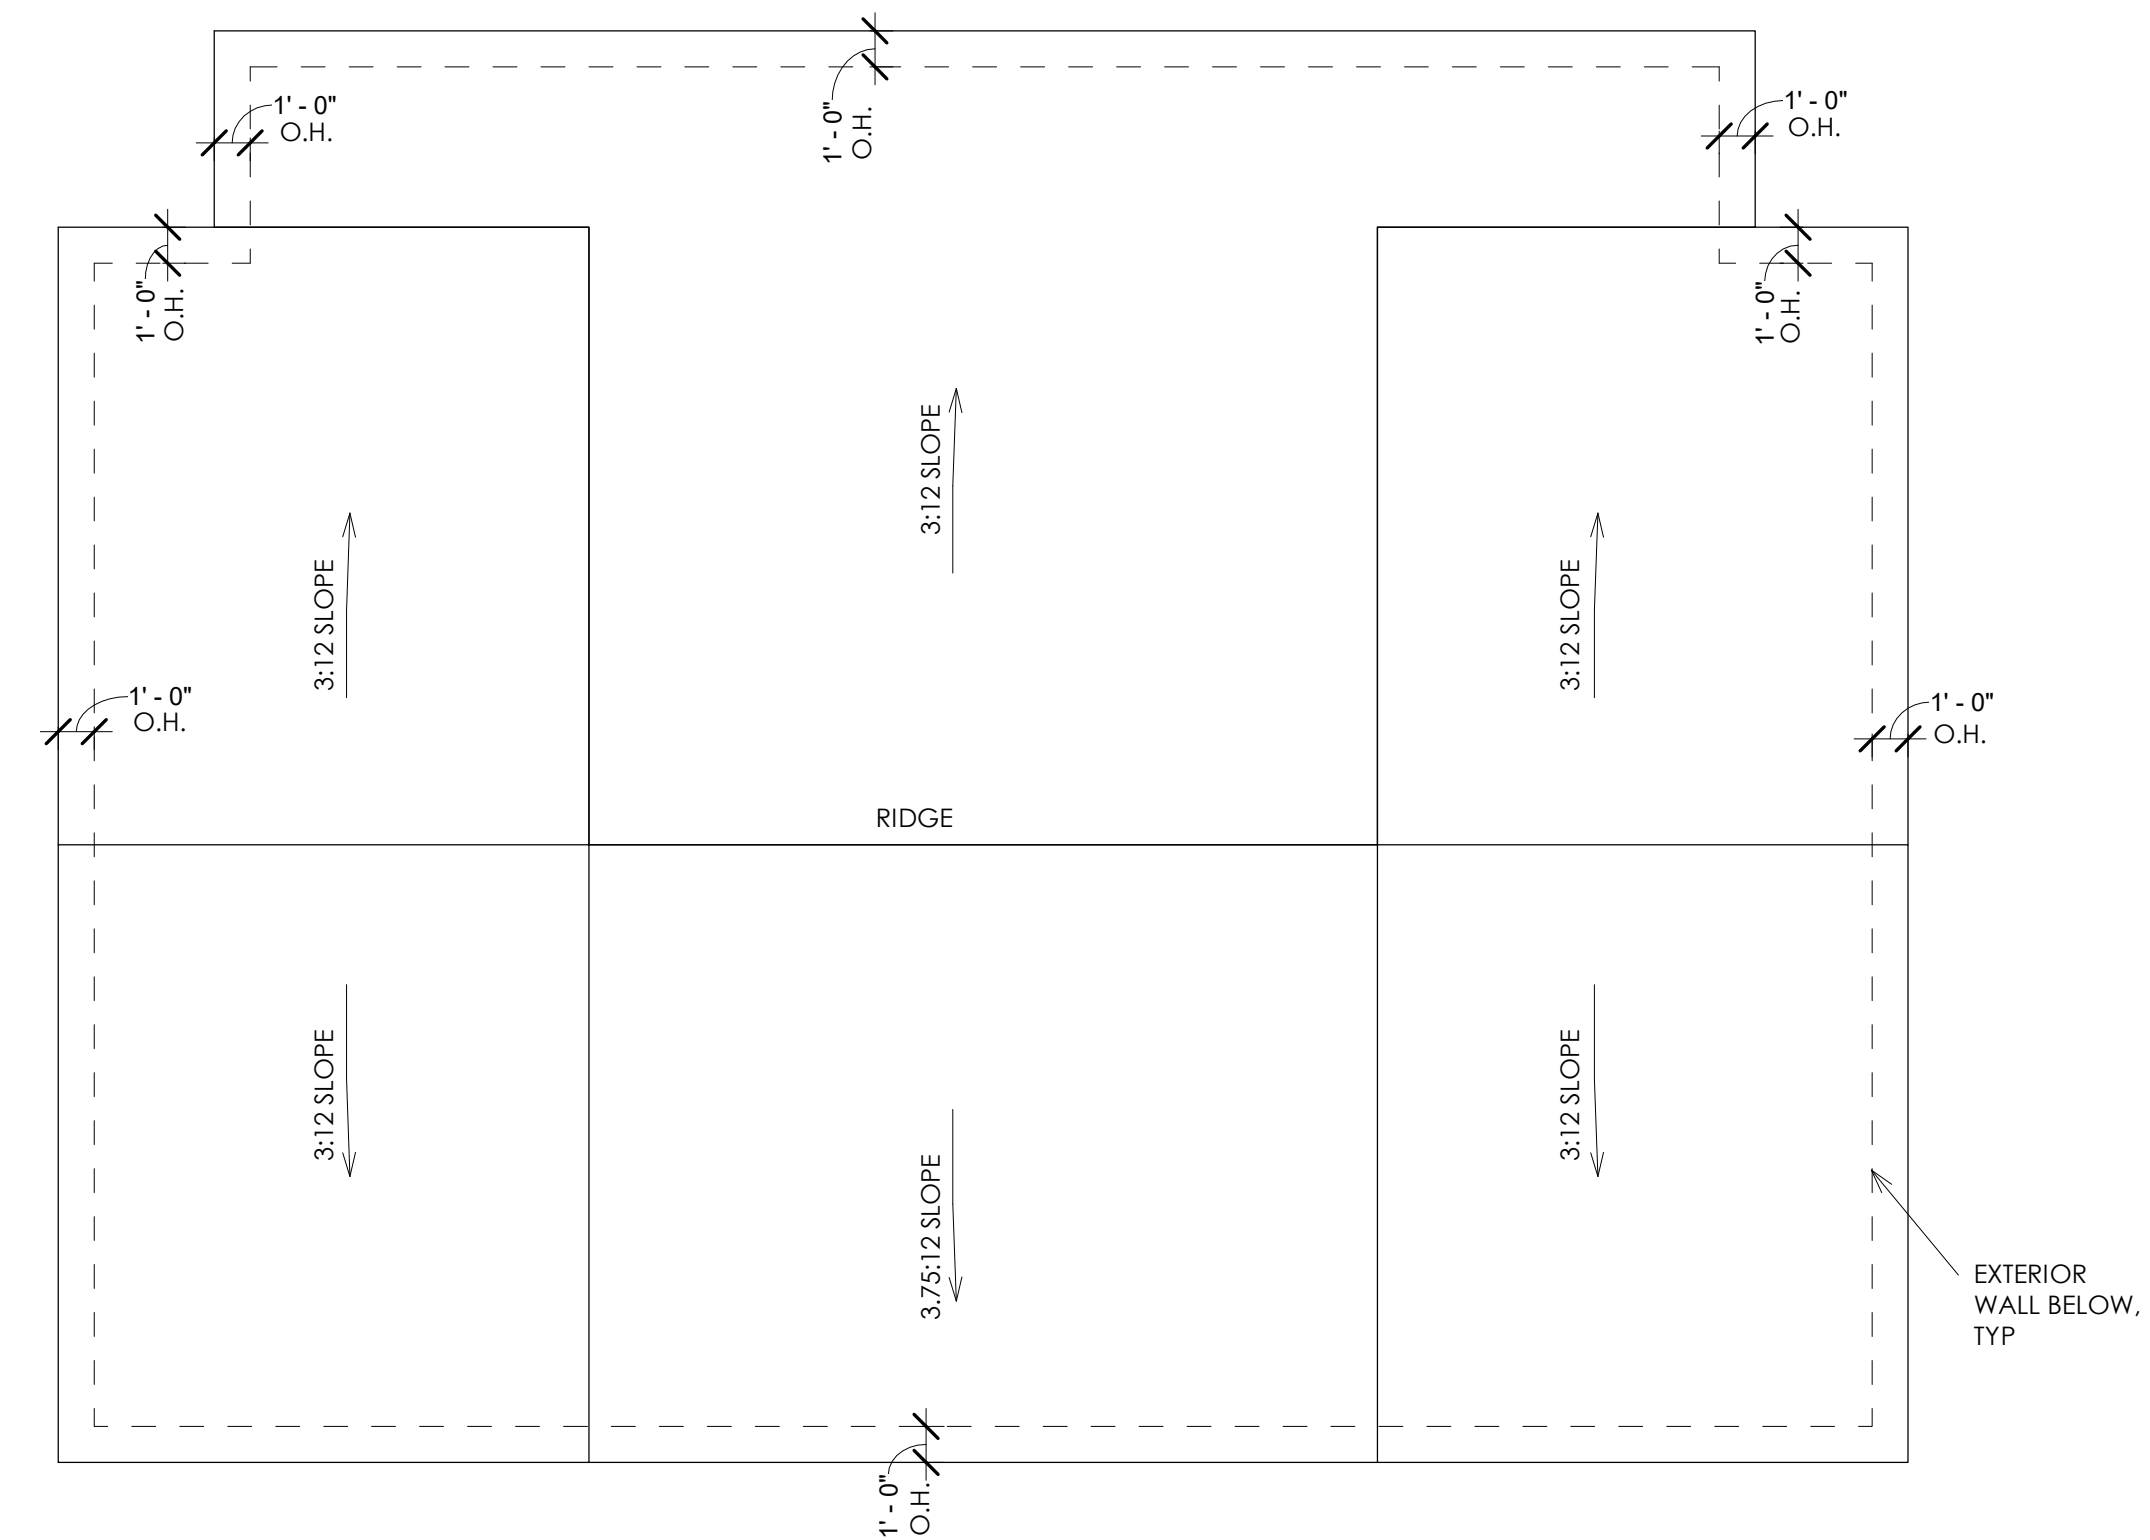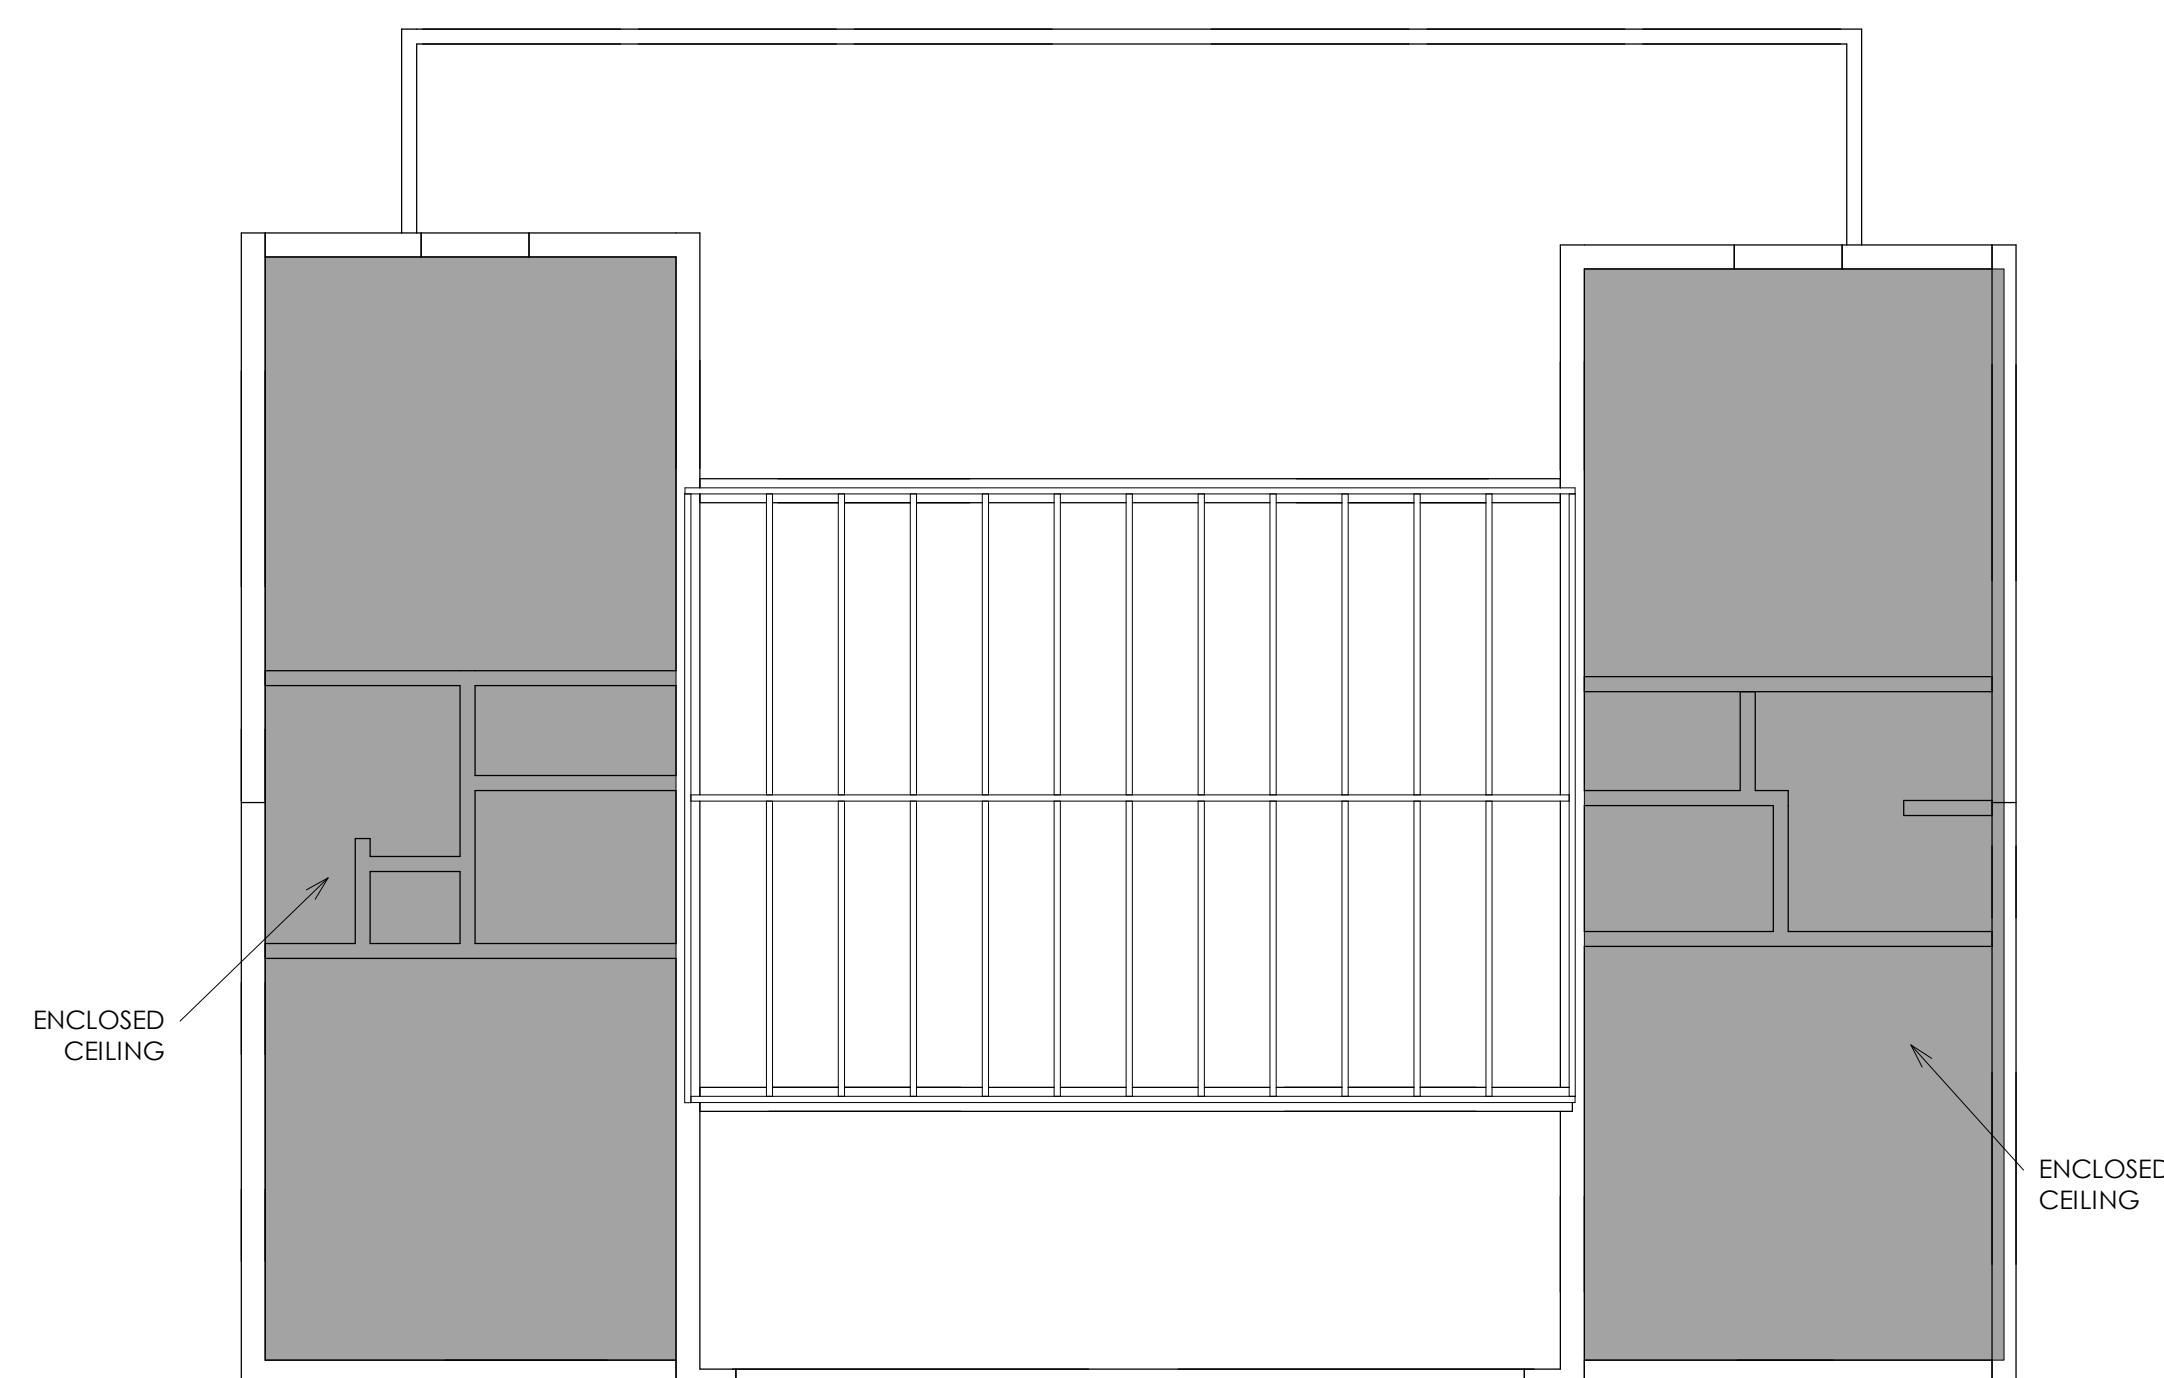

1 ROOF FRAMING PLAN  
3/16" = 1'-0"

2 ROOF PLAN  
3/16" = 1'-0"

PROJECT NAME:

116 OCEAN BLVD  
SOUTHERN SHORES  
NORTH CAROLINA

REVISIONS:	DATE:
AS-BUILTS	6 / 26 / 19

DRAWING NAME:

ROOF PLAN

PRELIMINARY DRAWINGS  
NOT FOR  
CONSTRUCTION:

DRAWN BY: DF


DATE: 6 / 26 / 19

SCALE: SEE PLANS


STAMP:

SHEET:


A1.2

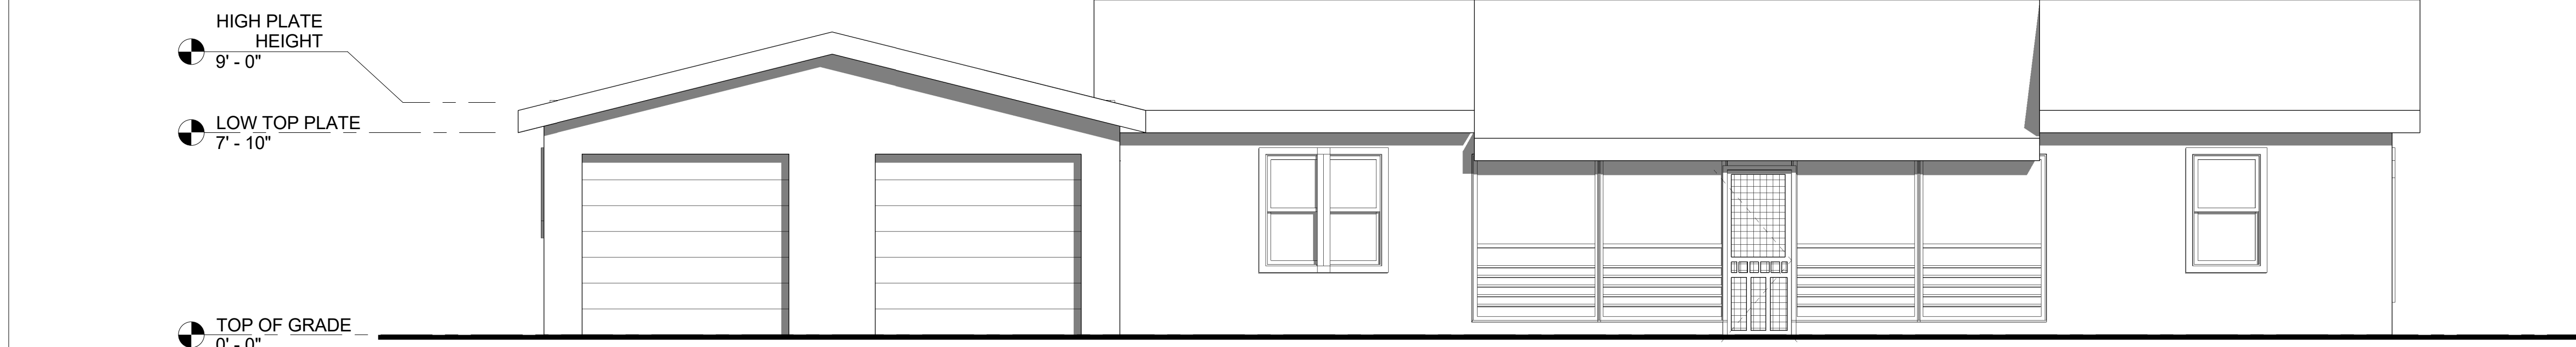


1 EXTERIOR ELEVATION 1  
1/4" = 1'-0"

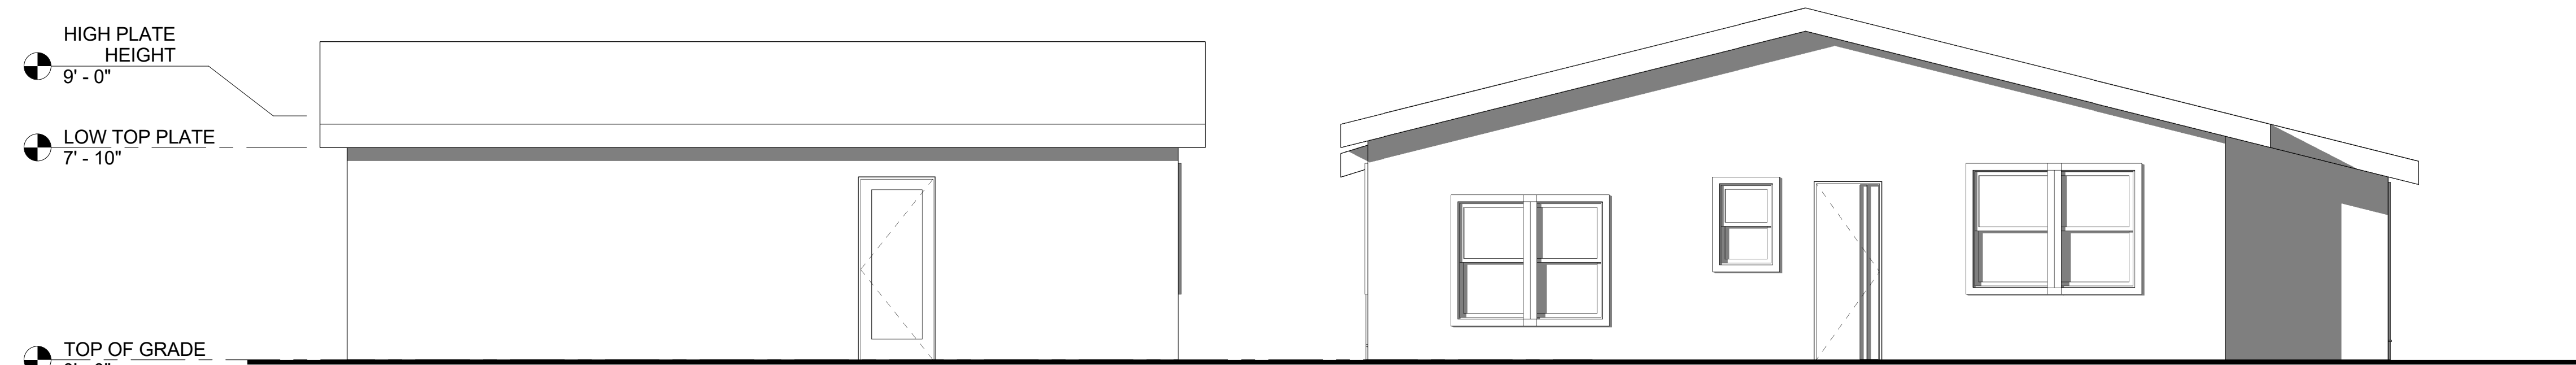

2 EXTERIOR ELEVATION 2  
1/4" = 1'-0"

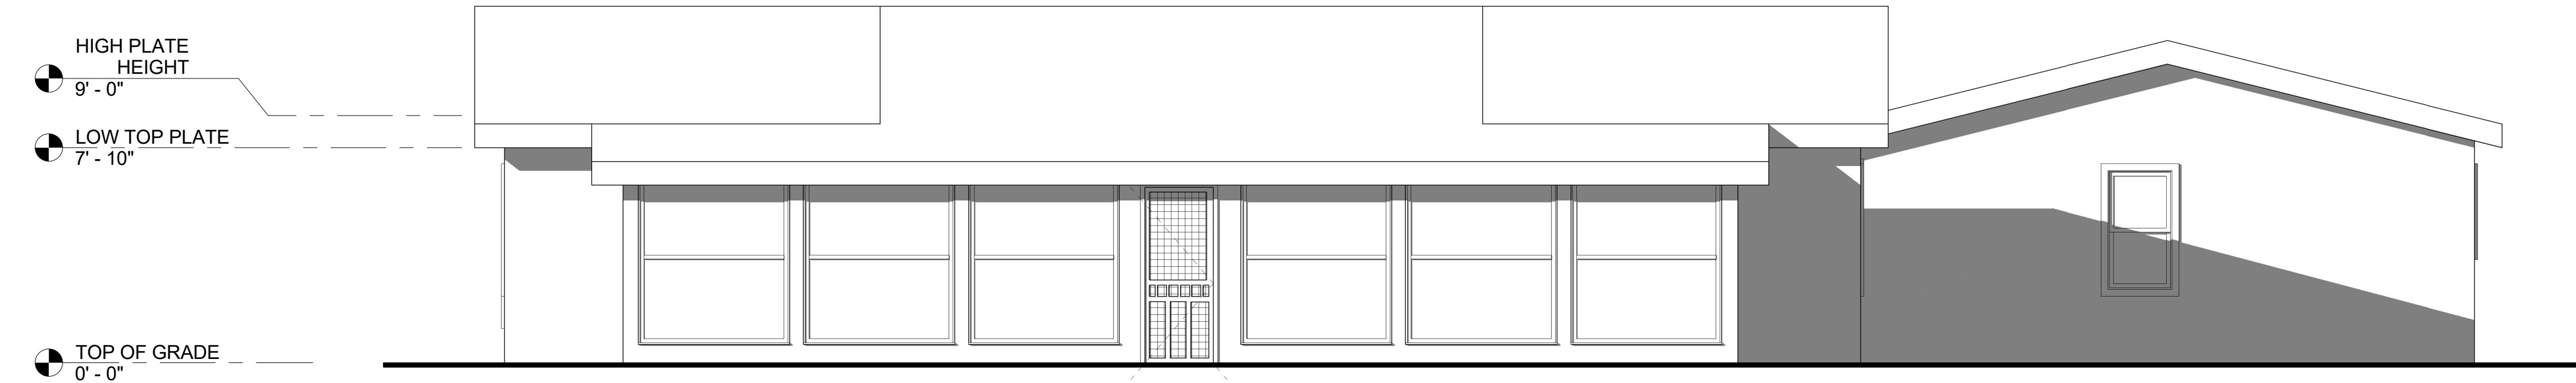

3 EXTERIOR ELEVATION 3  
1/4" = 1'-0"

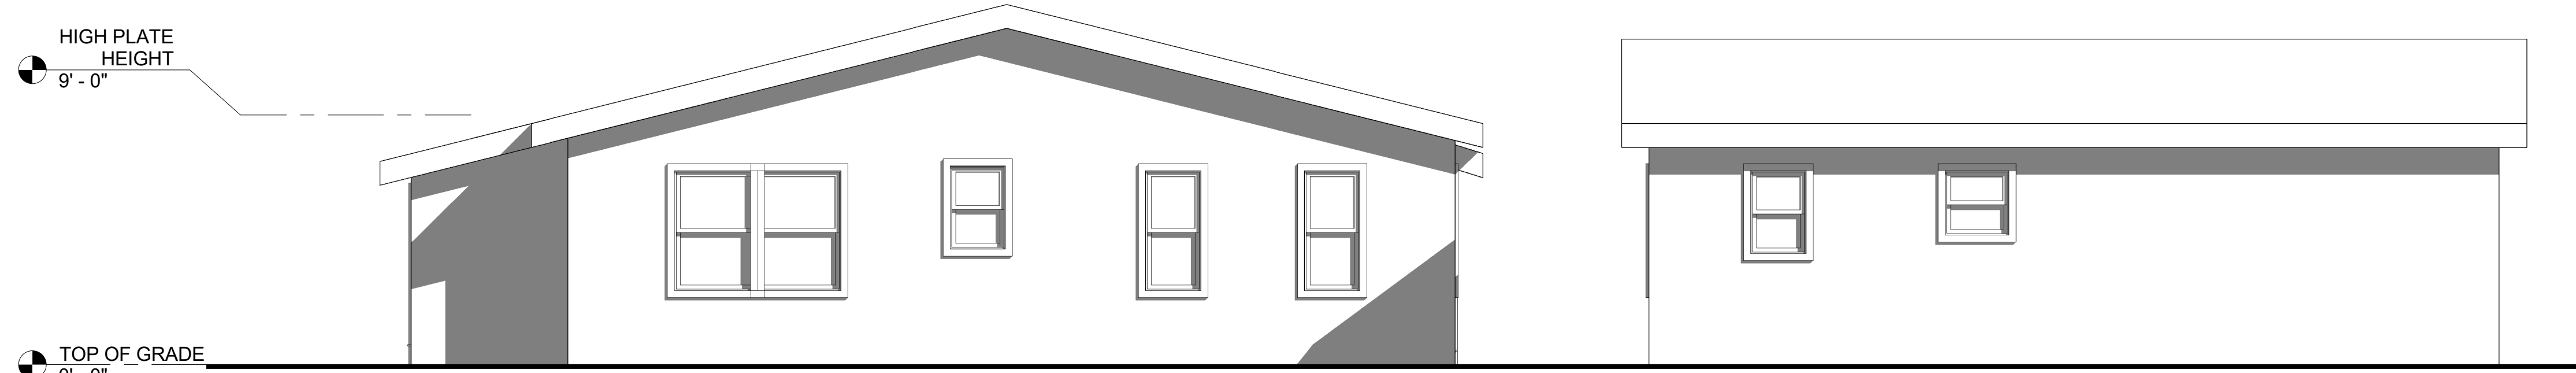

4 EXTERIOR ELEVATION 4  
1/4" = 1'-0"

PROJECT NAME:  
  
116 OCEAN BLVD  
SOUTHERN SHORES  
NORTH CAROLINA

REVISIONS:	DATE:
AS-BUILTS	6 / 26 / 19

DRAWING NAME:  
  
ELEVATIONS

PRELIMINARY DRAWINGS  
NOT FOR  
CONSTRUCTION:

DRAWN BY: DF

DATE: 6 / 26 / 19

SCALE: SEE PLANS

STAMP:

SHEET:  
**A2.1**