


① FRONT PERSPECTIVE

## LIST OF DRAWINGS

### ARCHITECTURAL DRAWINGS

- T1.1 TITLE SHEET
- A1.1 FIRST FLOOR
- A1.2 ROOF FRAMING PLAN & ROOF PLAN
- A2.1 ELEVATIONS

# 170 OCEAN BLVD, SOUTHERN SHORES, NORTH CAROLINA

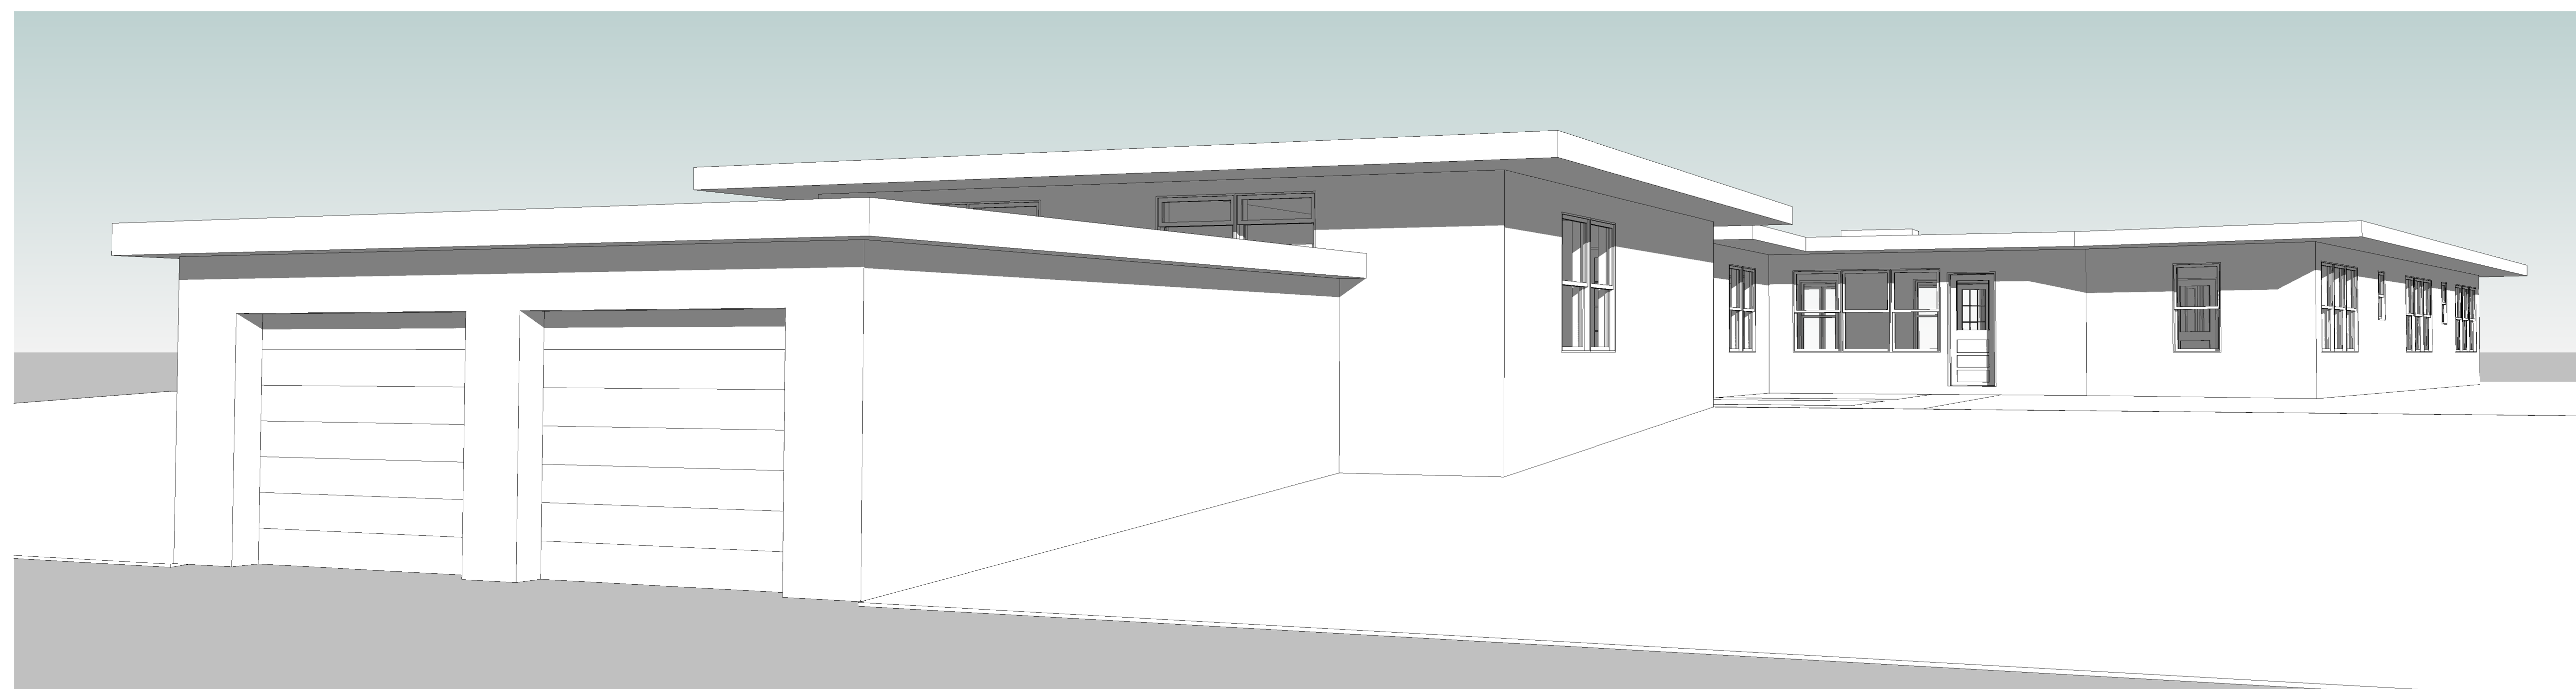

② FRONT PERSPECTIVE 2

PROJECT NAME:

170 OCEAN BLVD  
SOUTHERN SHORES  
NORTH CAROLINA

REVISIONS:	DATE:
AS-BUILTS	8 / 23 / 19

DRAWING NAME:

TITLE SHEET

PRELIMINARY DRAWINGS  
NOT FOR  
CONSTRUCTION:

DRAWN BY: DF


DATE: 8 / 23 / 19

SCALE: SEE PLANS

STAMP:

SHEET:

T1.1

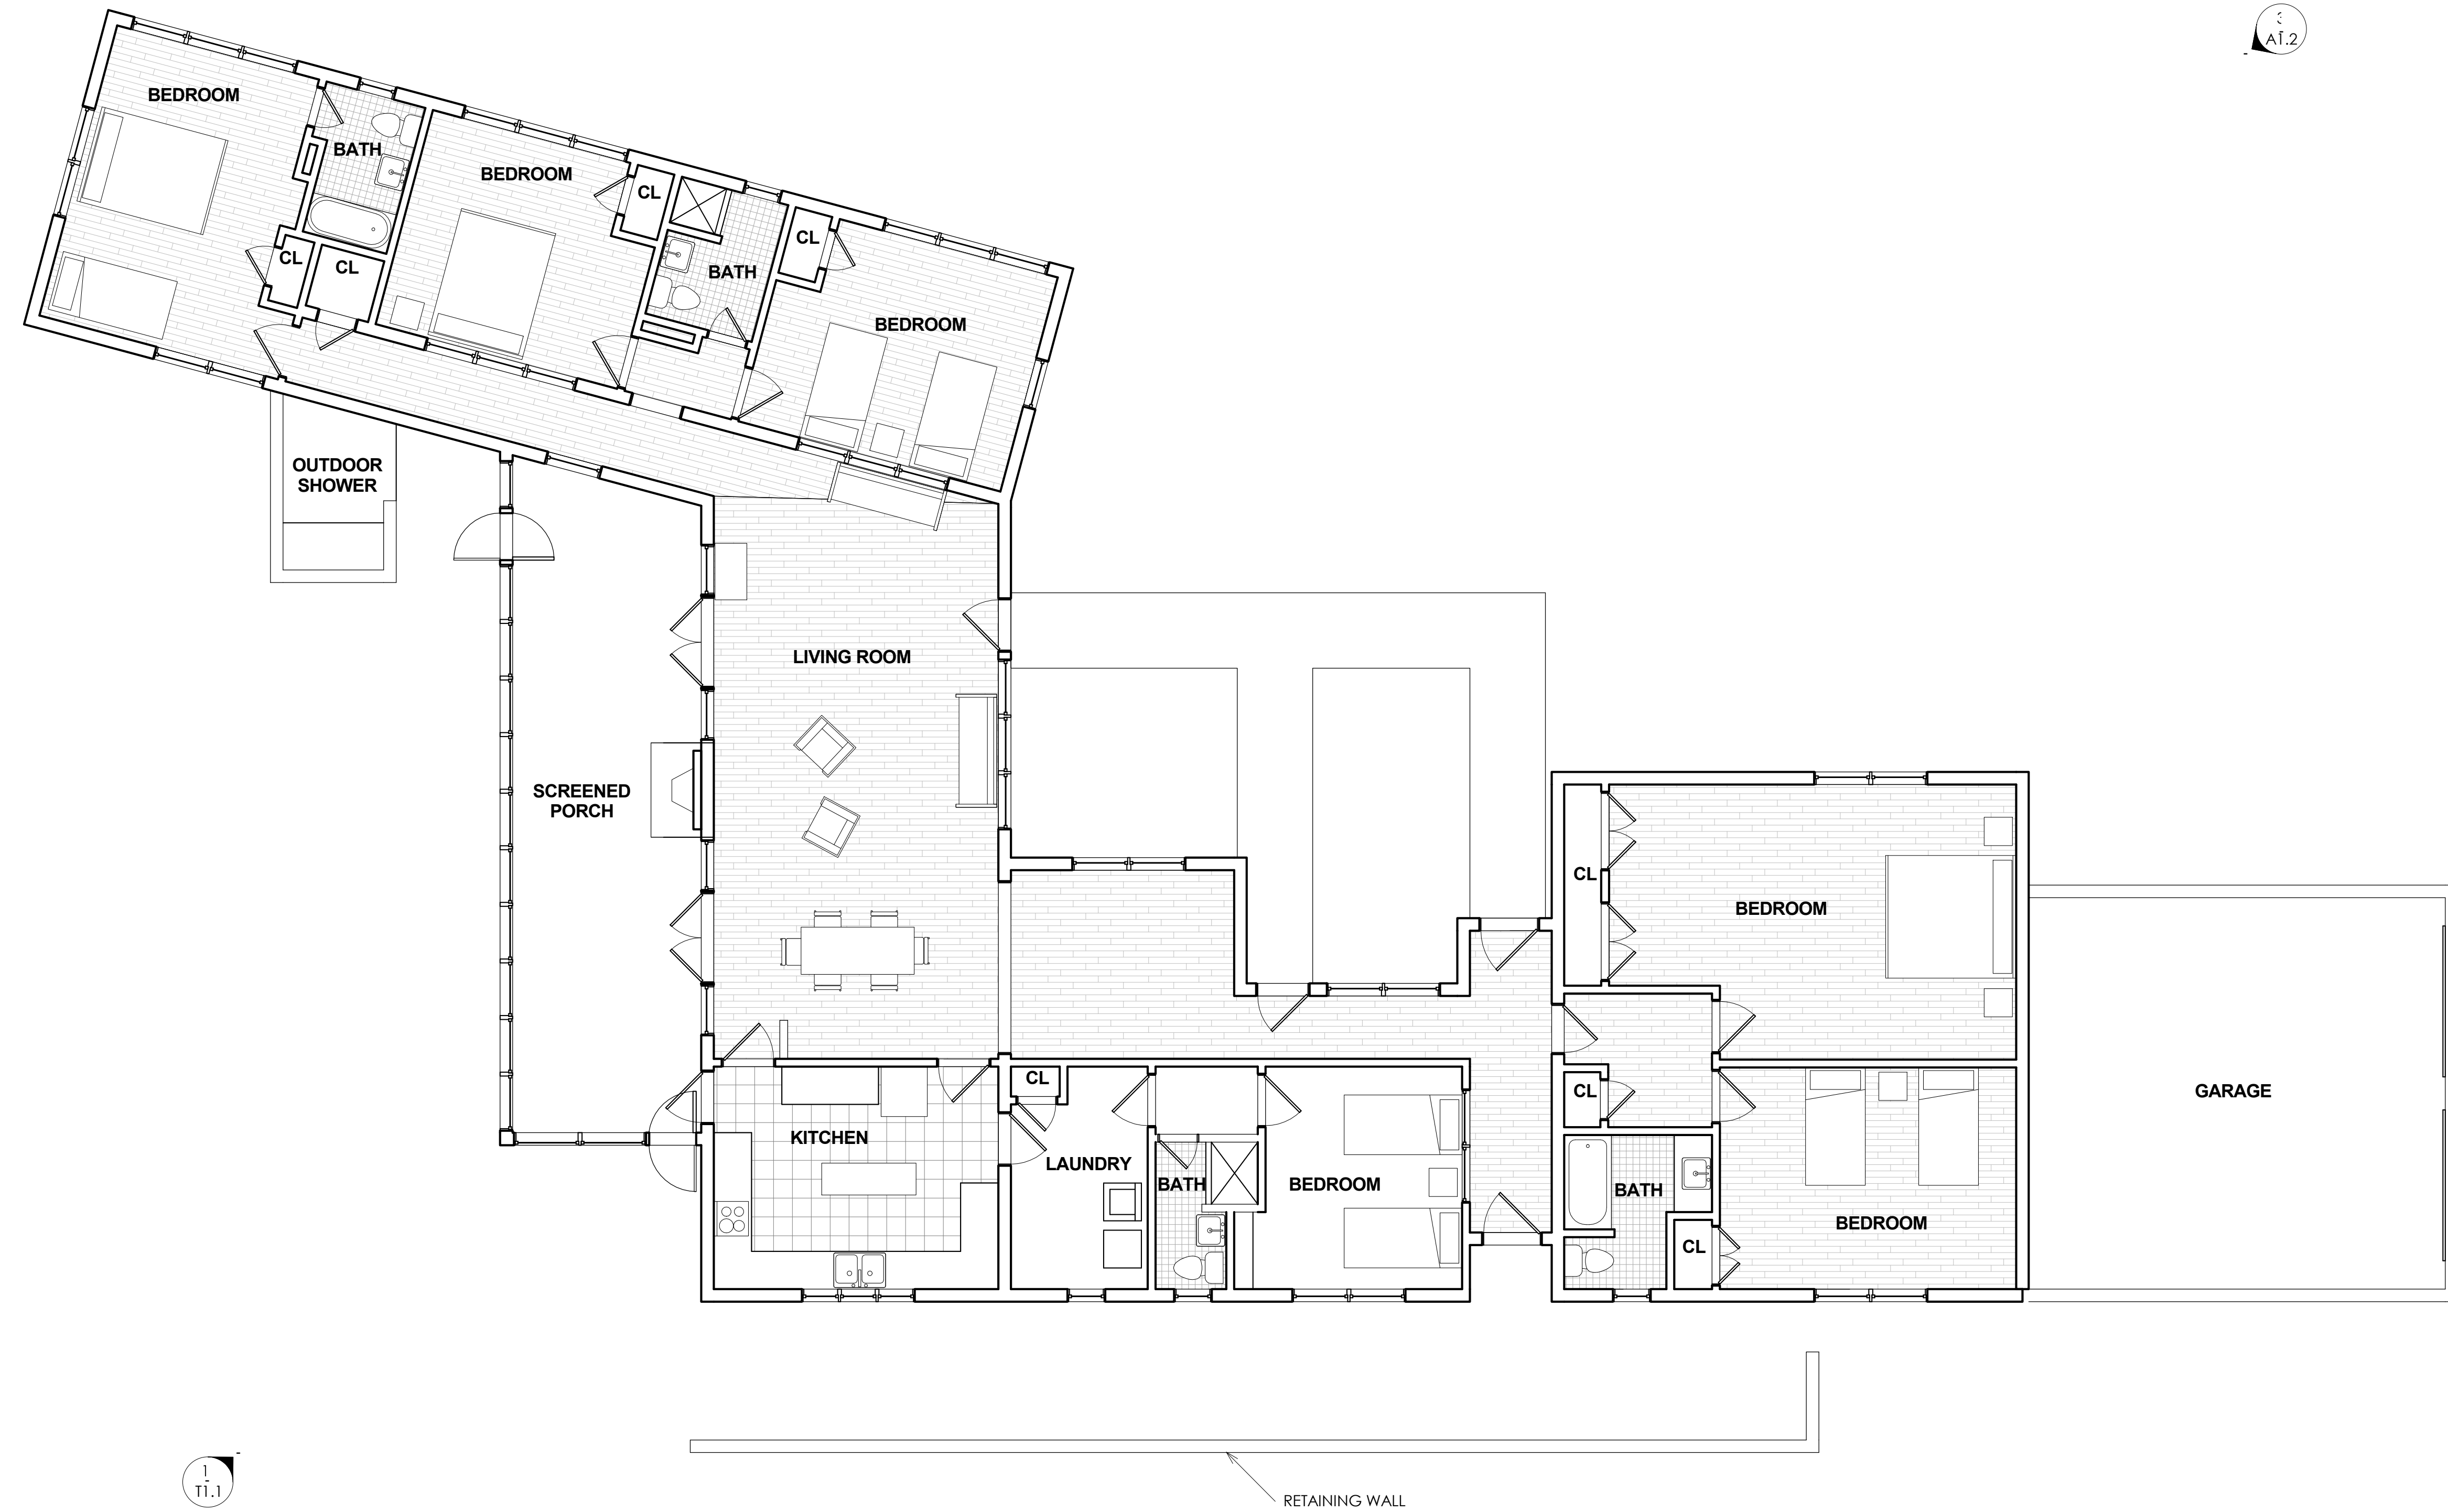

PROJECT NAME:  
 170 OCEAN BLVD  
 SOUTHERN SHORES  
 NORTH CAROLINA

REVISIONS:	DATE:
AS-BUILTS	8 / 23 / 19

DRAWING NAME:  
**FIRST FLOOR PLAN**

PRELIMINARY DRAWINGS  
 NOT FOR  
 CONSTRUCTION:


DRAWN BY: DF

DATE: 8 / 23 / 19


SCALE: SEE PLANS

STAMP:

SHEET:  
**A1.1**

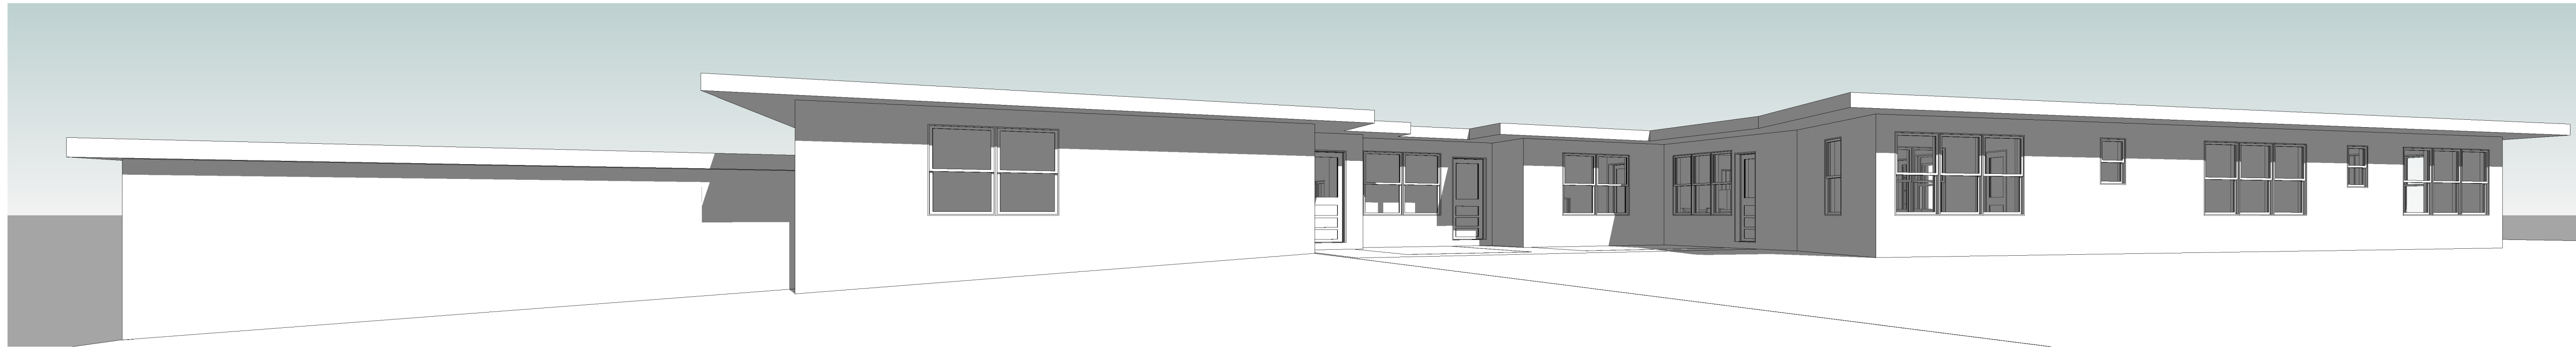

① SIDE PERSPECTIVE

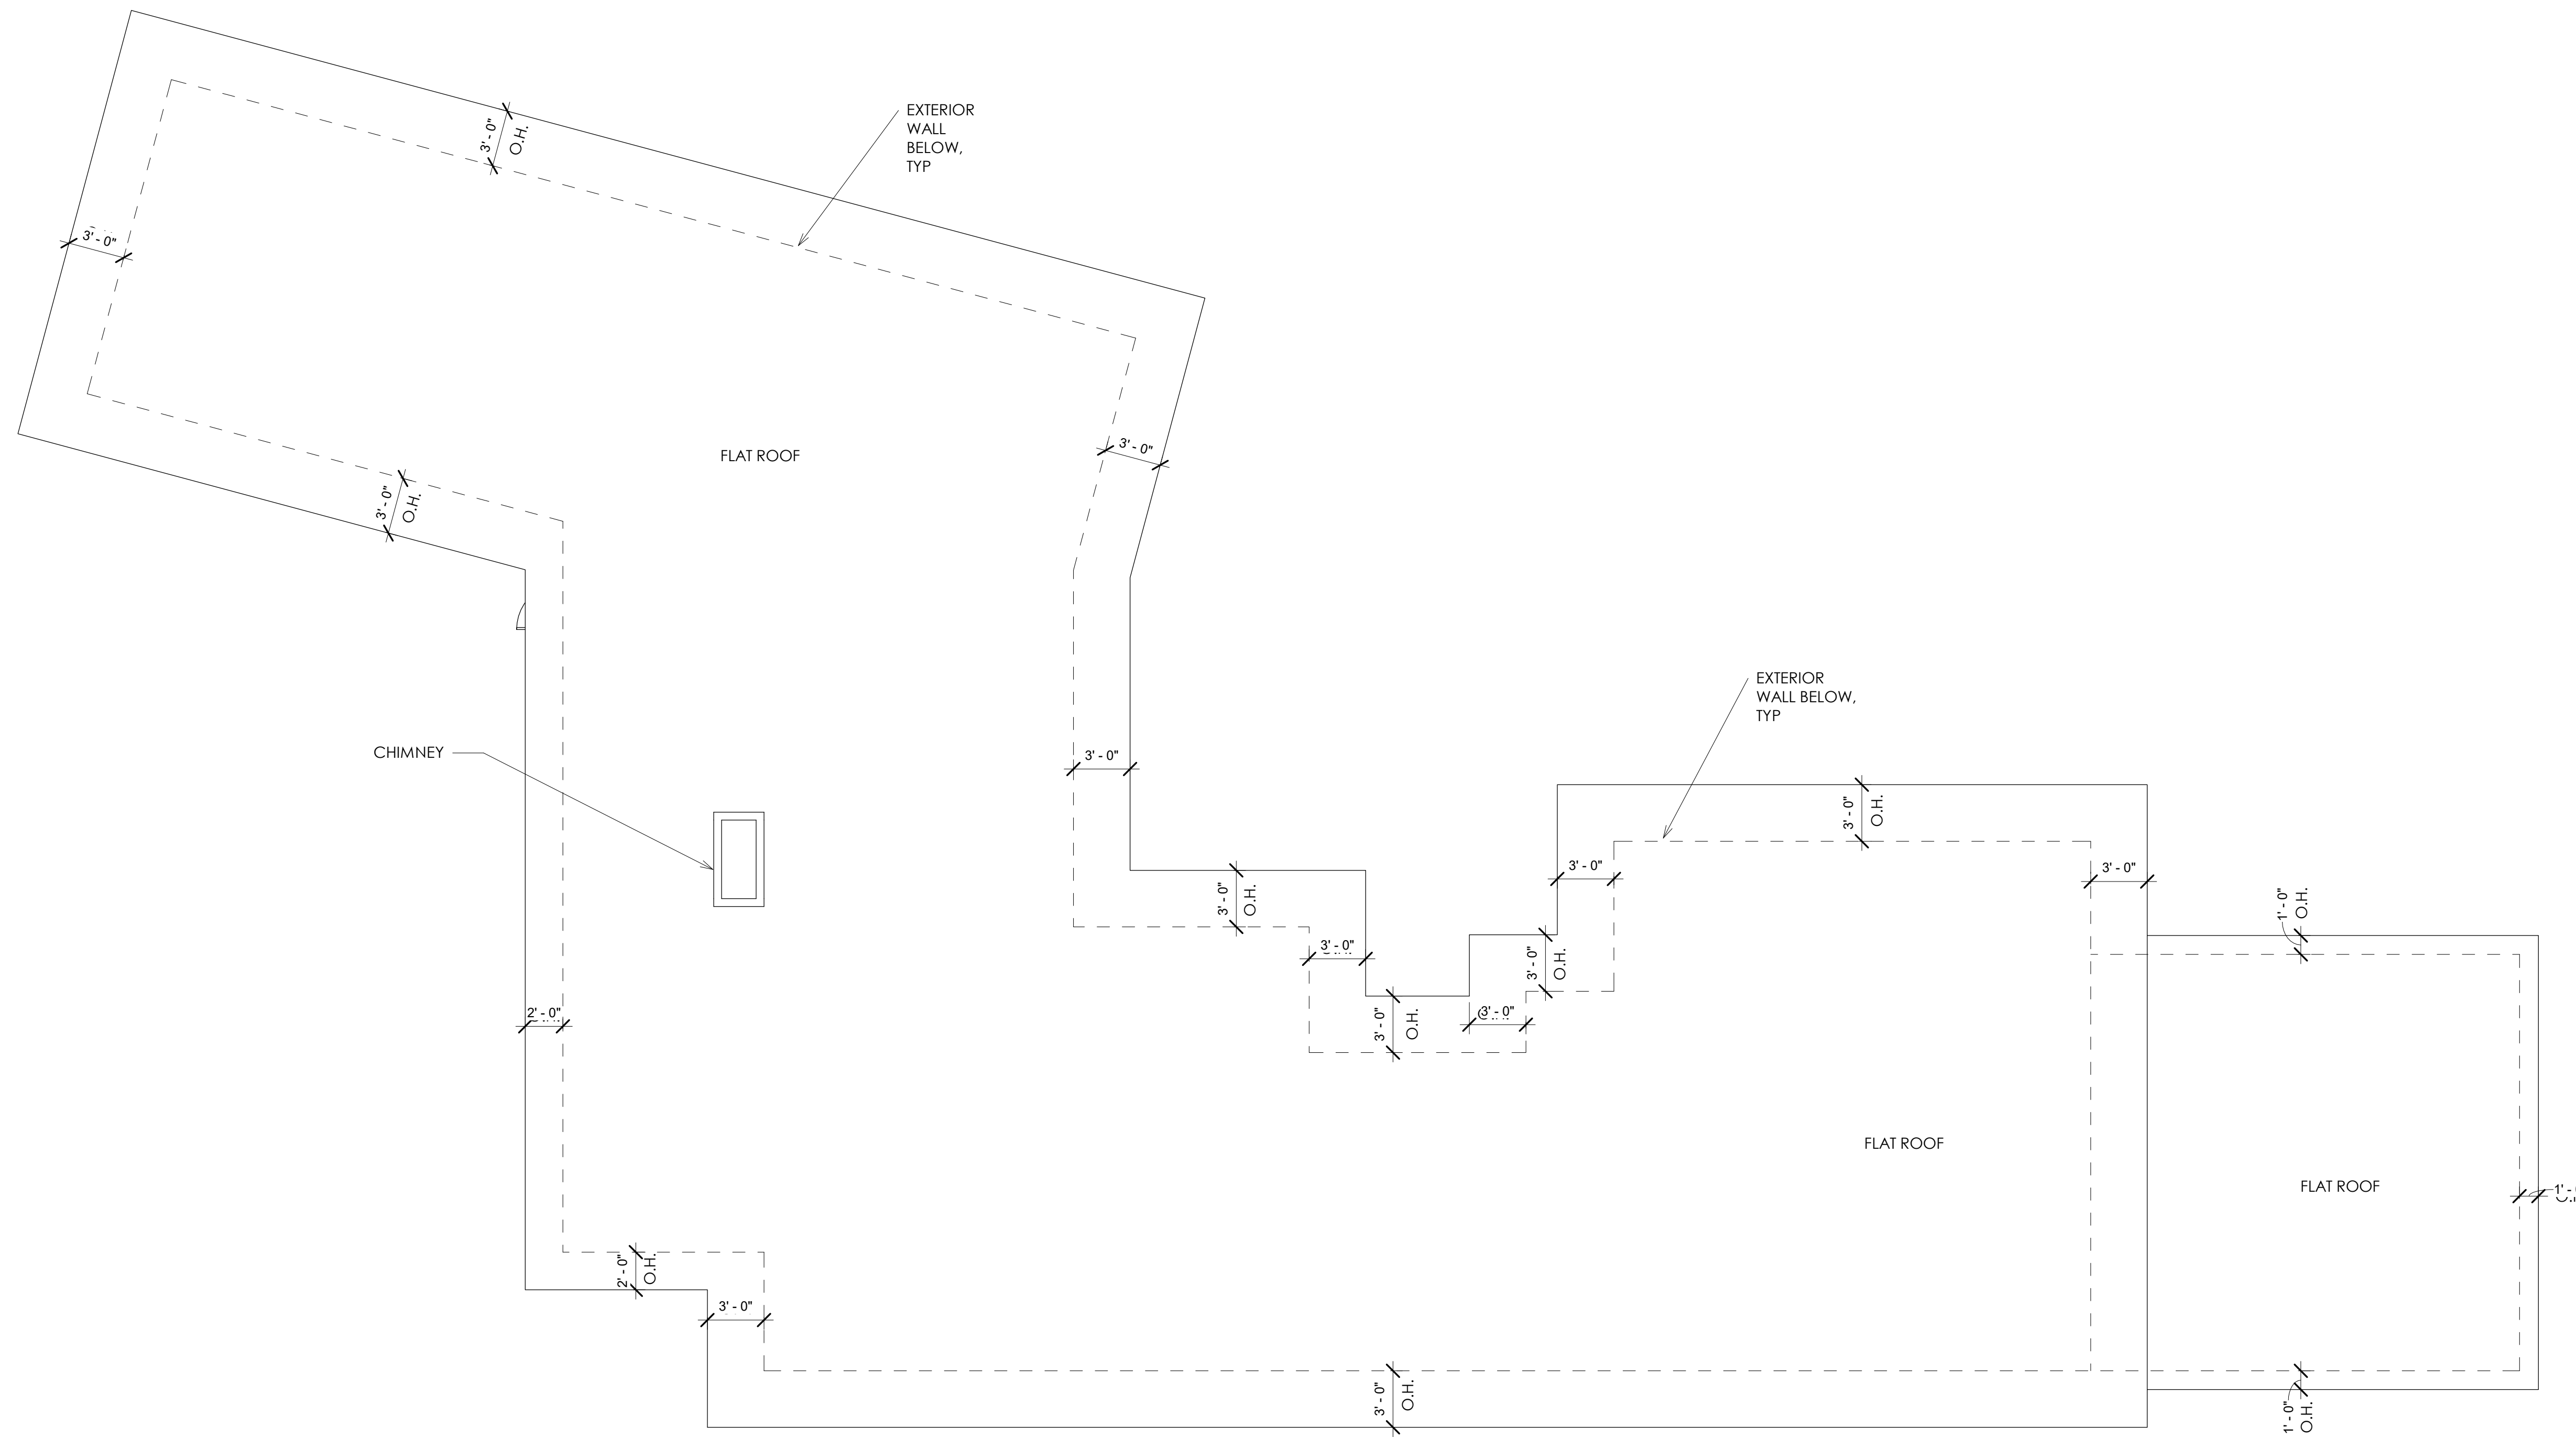

② ROOF PLAN  
3/16" = 1'-0"

PROJECT NAME:

170 OCEAN BLVD  
SOUTHERN SHORES  
NORTH CAROLINA

REVISIONS:	DATE:
AS-BUILTS	8 / 23 / 19

DRAWING NAME:

ROOF PLAN

PRELIMINARY DRAWINGS  
NOT FOR  
CONSTRUCTION:

DRAWN BY: DF

DATE: 8 / 23 / 19

SCALE: SEE PLANS

STAMP:

SHEET:

A1.2

ROOF PLAN  
11'-6"

GARAGE TOP  
PLATE  
8'-0"

TOP OF MAIN  
GRADE  
3'-6"

TOP OF LOW  
GRADE  
0'-0"

1 EXTERIOR ELEVATION 1  
3/16" = 1'-0"

ROOF PLAN  
11'-6"

GARAGE TOP  
PLATE  
8'-0"

TOP OF MAIN  
GRADE  
3'-6"

TOP OF LOW  
GRADE  
0'-0"

2 EXTERIOR ELEVATION 2  
3/16" = 1'-0"

ROOF PLAN  
11'-6"

TOP OF MAIN  
GRADE  
3'-6"

GARAGE TOP  
PLATE  
8'-0"

3 EXTERIOR ELEVATION 3  
3/16" = 1'-0"

ROOF PLAN  
11'-6"

TOP OF MAIN  
GRADE  
3'-6"

GARAGE TOP  
PLATE  
8'-0"

TOP OF LOW  
GRADE  
0'-0"

4 EXTERIOR ELEVATION 4  
3/16" = 1'-0"

PROJECT NAME:

170 OCEAN BLVD  
SOUTHERN SHORES  
NORTH CAROLINA

REVISIONS:

DATE:

AS-BUILTS

8 / 23 / 19

DRAWING NAME:

ELEVATIONS

PRELIMINARY DRAWINGS  
NOT FOR  
CONSTRUCTION:

DRAWN BY:

DF

DATE:

8 / 23 / 19

SCALE:

SEE PLANS

STAMP:

SHEET:

A2.1