

① FRONT PERSPECTIVE 1

PROJECT NAME:

6 YELLOWFIN LANE
 SOUTHERN SHORES
 NORTH CAROLINA

REVISIONS:	DATE:
AS- BUILTS	2 / 25 / 19

DRAWING NAME:

TITLE SHEET

PRELIMINARY DRAWINGS
 NOT FOR
 CONSTRUCTION:

DRAWN BY: DF

DATE: 2 / 25 / 19

SCALE: SEE PLANS

STAMP:

© 2016 BEACON ARCHITECTURE +
 DESIGN
 P.L.L.C. - ALL RIGHTS RESERVED

SHEET:


T1.1

LIST OF DRAWINGS

ARCHITECTURAL DRAWINGS


- T1.1 TITLE SHEET
- A1.1 FIRST FLOOR
- A1.2 ROOF FRAMING PLAN & ROOF PLAN
- A2.1 ELEVATIONS

218 OCEAN BLVD, SOUTHERN SHORES, NORTH CAROLINA

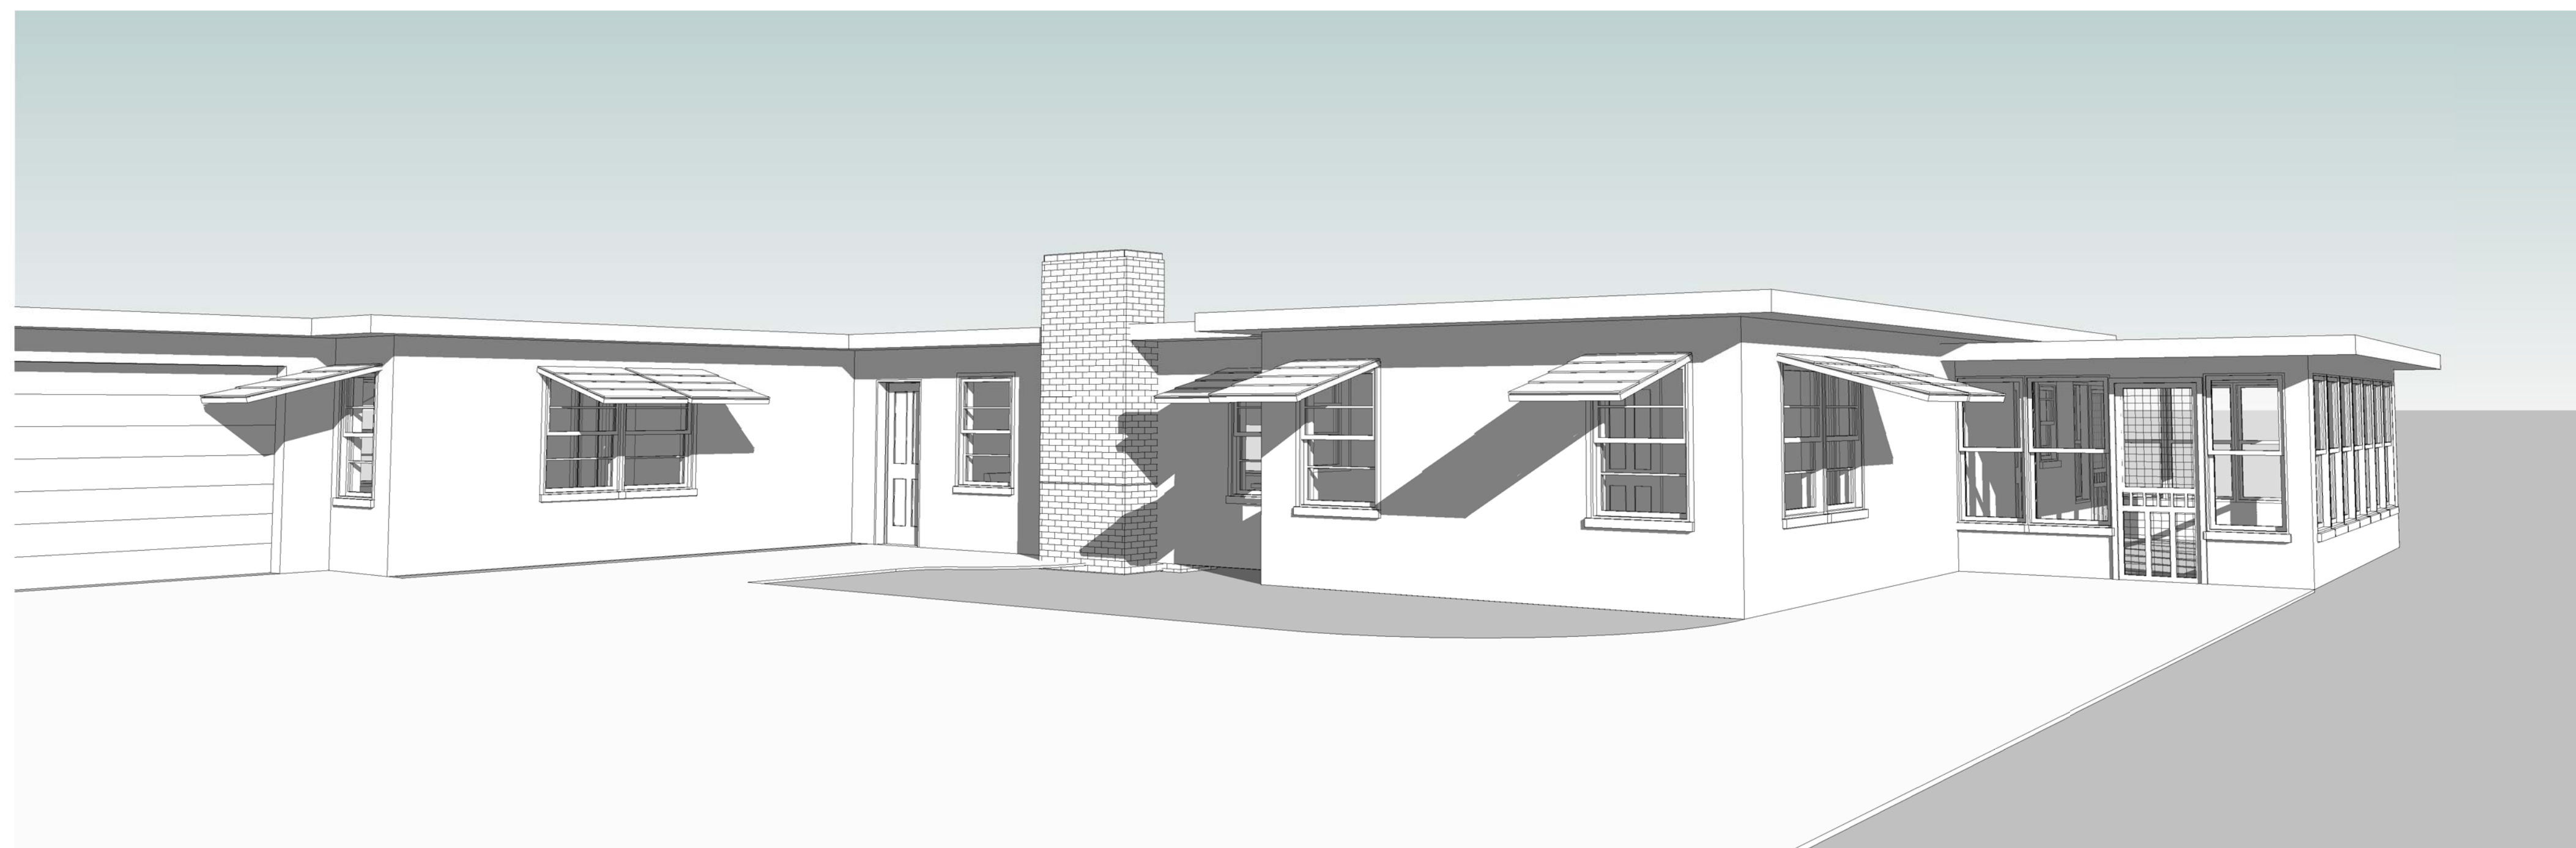


② FRONT PERSPECTIVE 2

SEE 1/A1.1 FOR MORE INFO

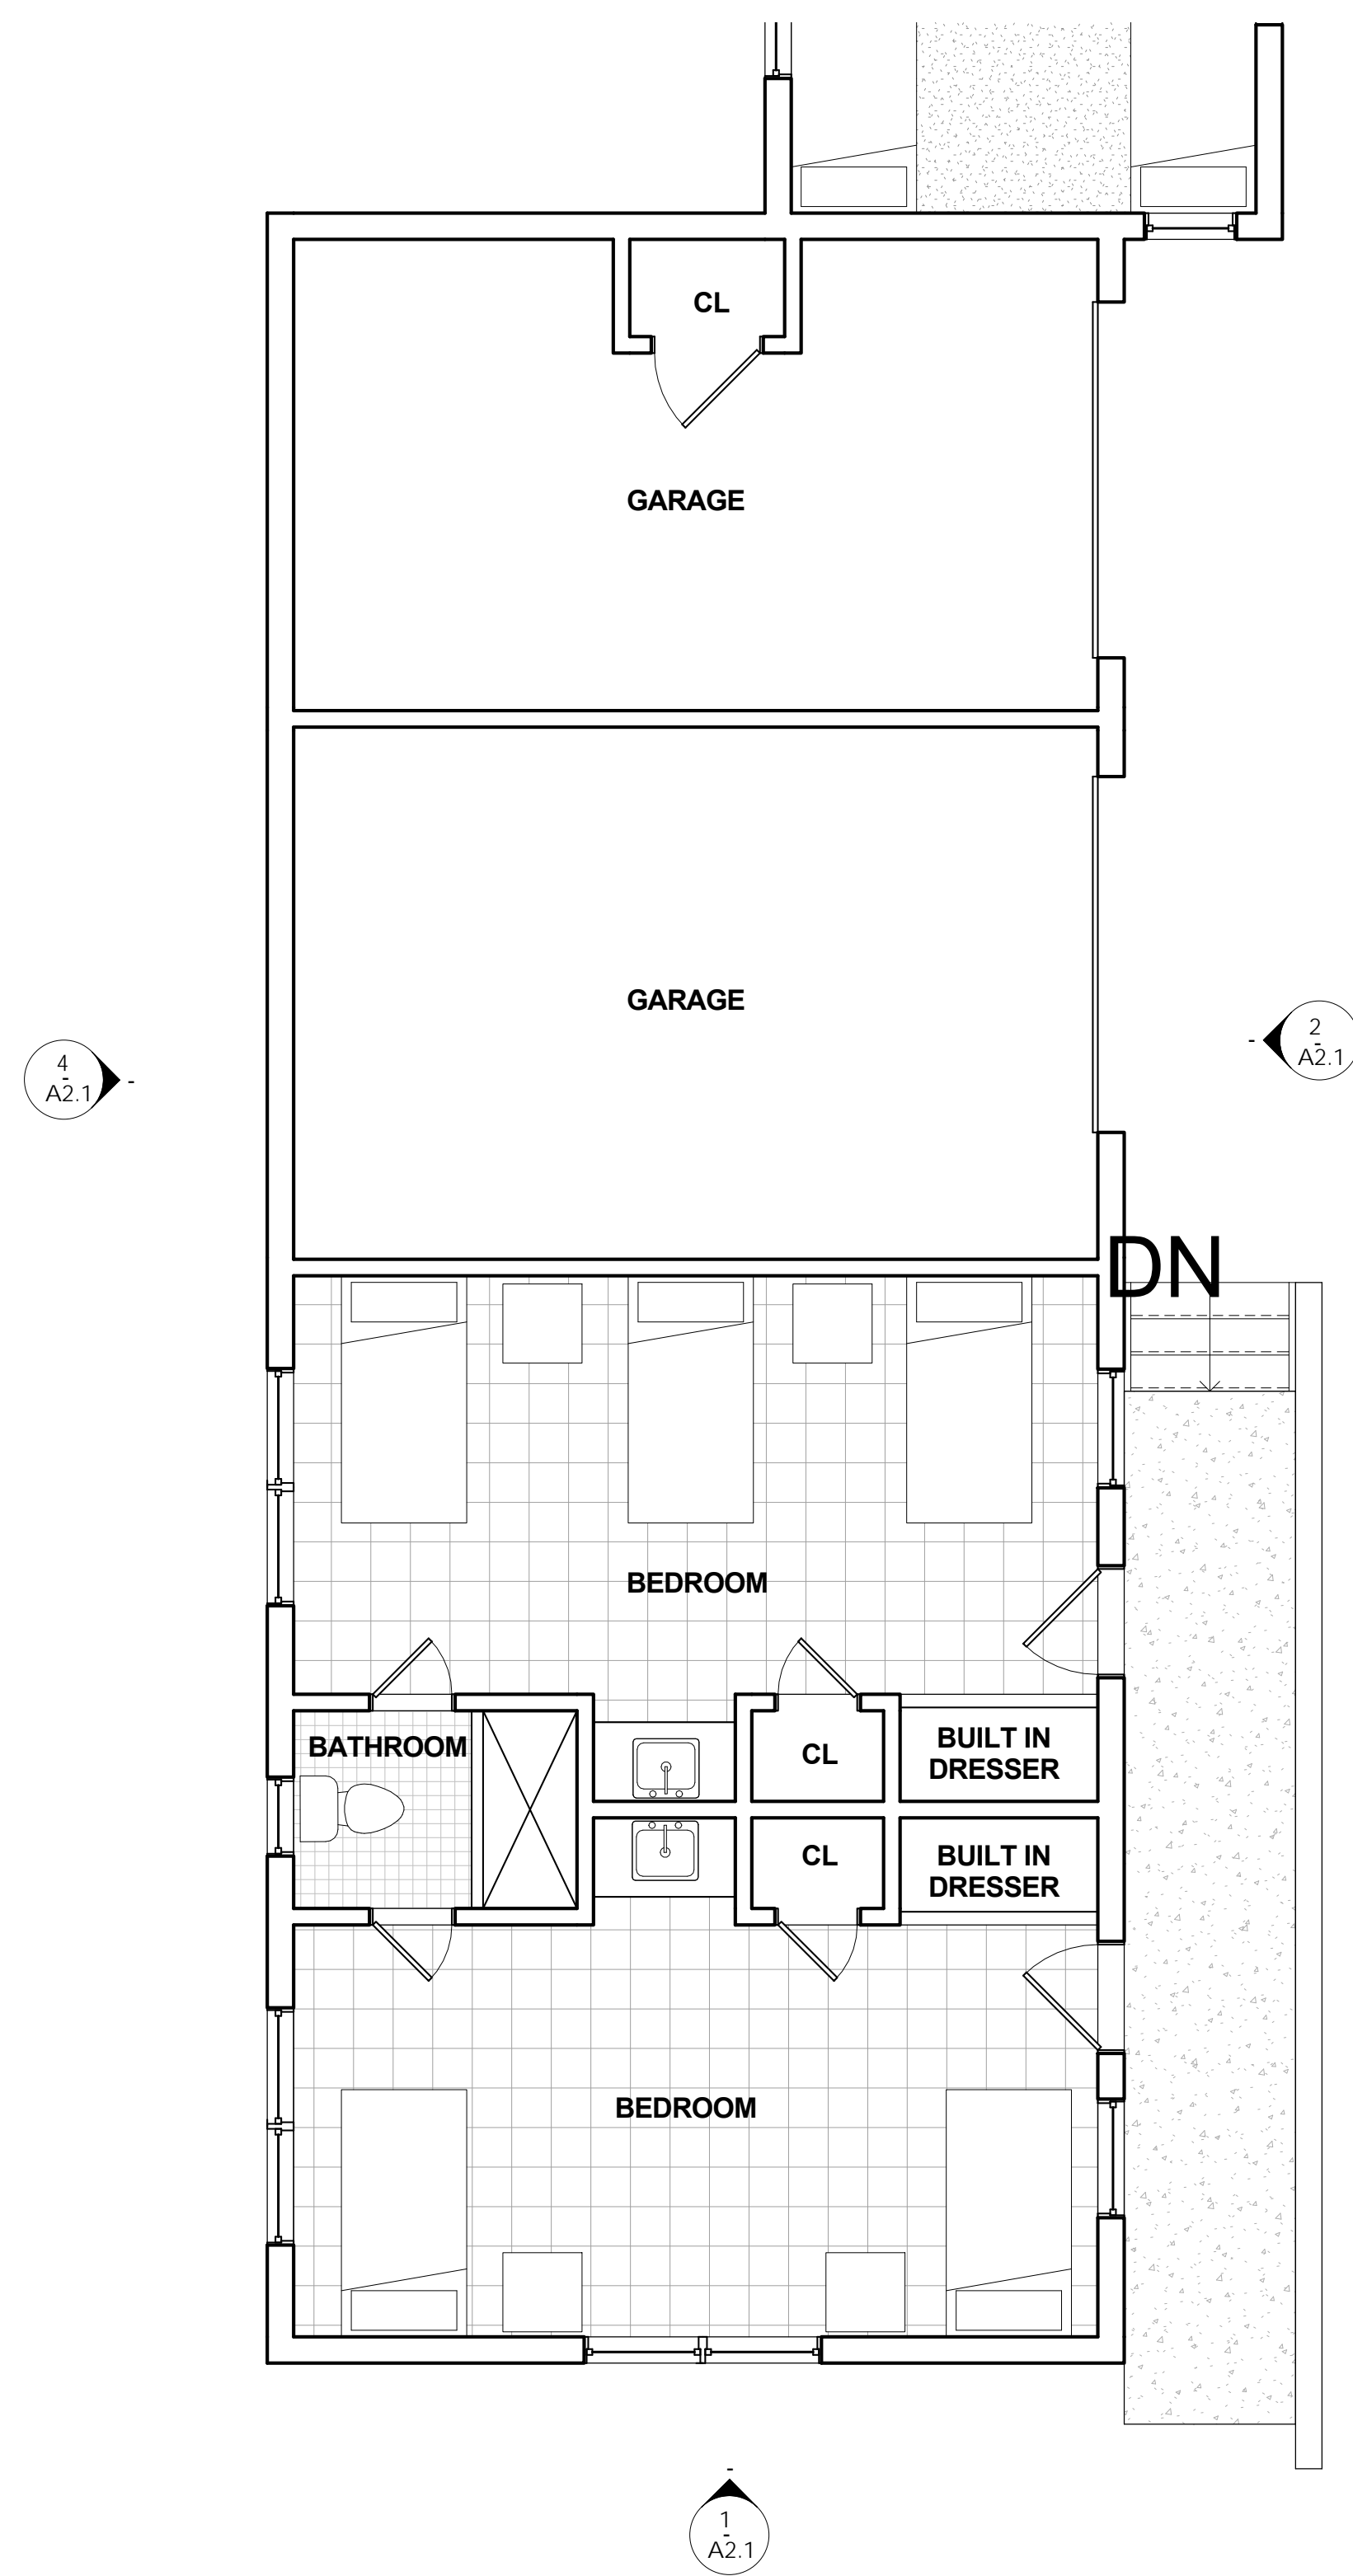

2 GARAGE FLOOR PLAN
1/4" = 1'-0"

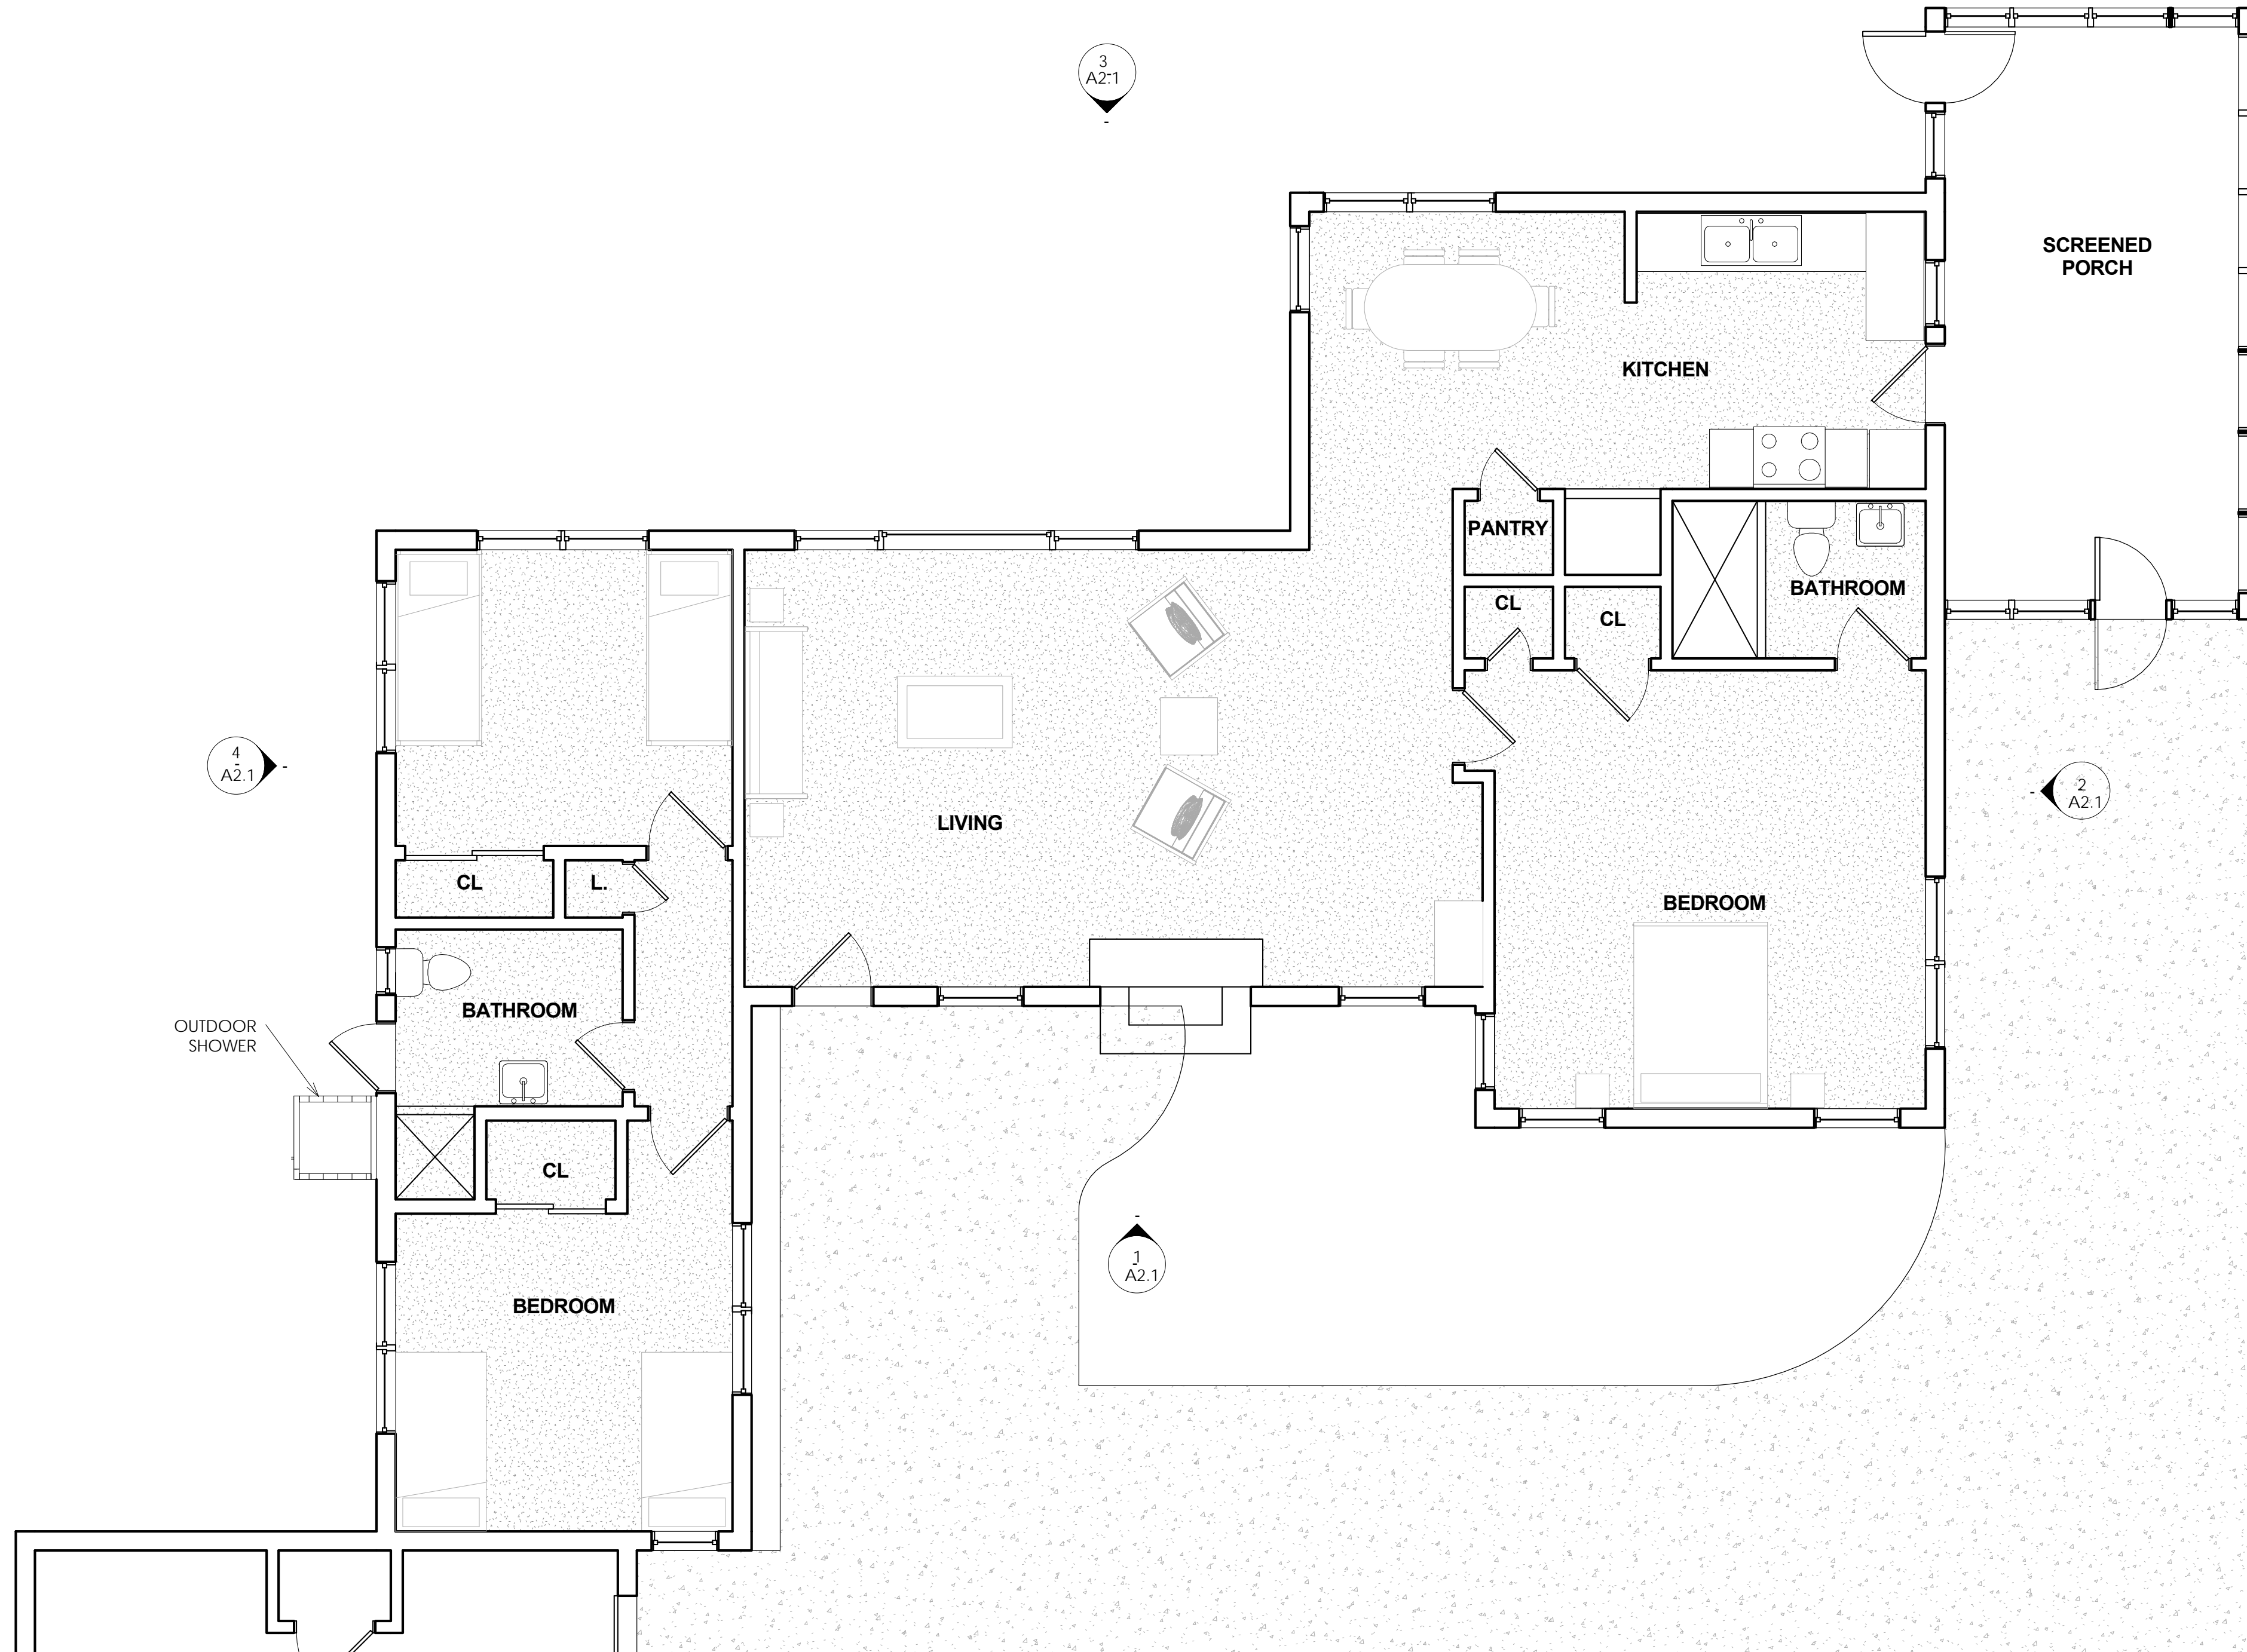

SEE 2/A1.1 FOR MORE INFO

1 FIRST FLOOR PLAN
1/4" = 1'-0"

PROJECT NAME:

6 YELLOWFIN LANE
SOUTHERN SHORES
NORTH CAROLINA

REVISIONS:	DATE:
AS-BUILTS	2 / 25 / 19

DRAWING NAME:

FIRST FLOOR
PLAN

PRELIMINARY DRAWINGS
NOT FOR
CONSTRUCTION:

DRAWN BY: DF

DATE: 2 / 25 / 19

SCALE: SEE PLANS

STAMP:

SHEET:

A1.1

PROJECT NAME:
 6 YELLOWFIN LANE
 SOUTHERN SHORES
 NORTH CAROLINA

REVISIONS:	DATE:
AS- BUILTS	2 / 25 / 19

DRAWING NAME:
ROOF FRAMING PLAN

PRELIMINARY DRAWINGS
 NOT FOR
 CONSTRUCTION:

DRAWN BY: DF


DATE: 2 / 25 / 19

SCALE: SEE PLANS

STAMP:


© 2016 BEACON ARCHITECTURE + DESIGN P.L.L.C. - ALL RIGHTS RESERVED

SHEET:
A1.2

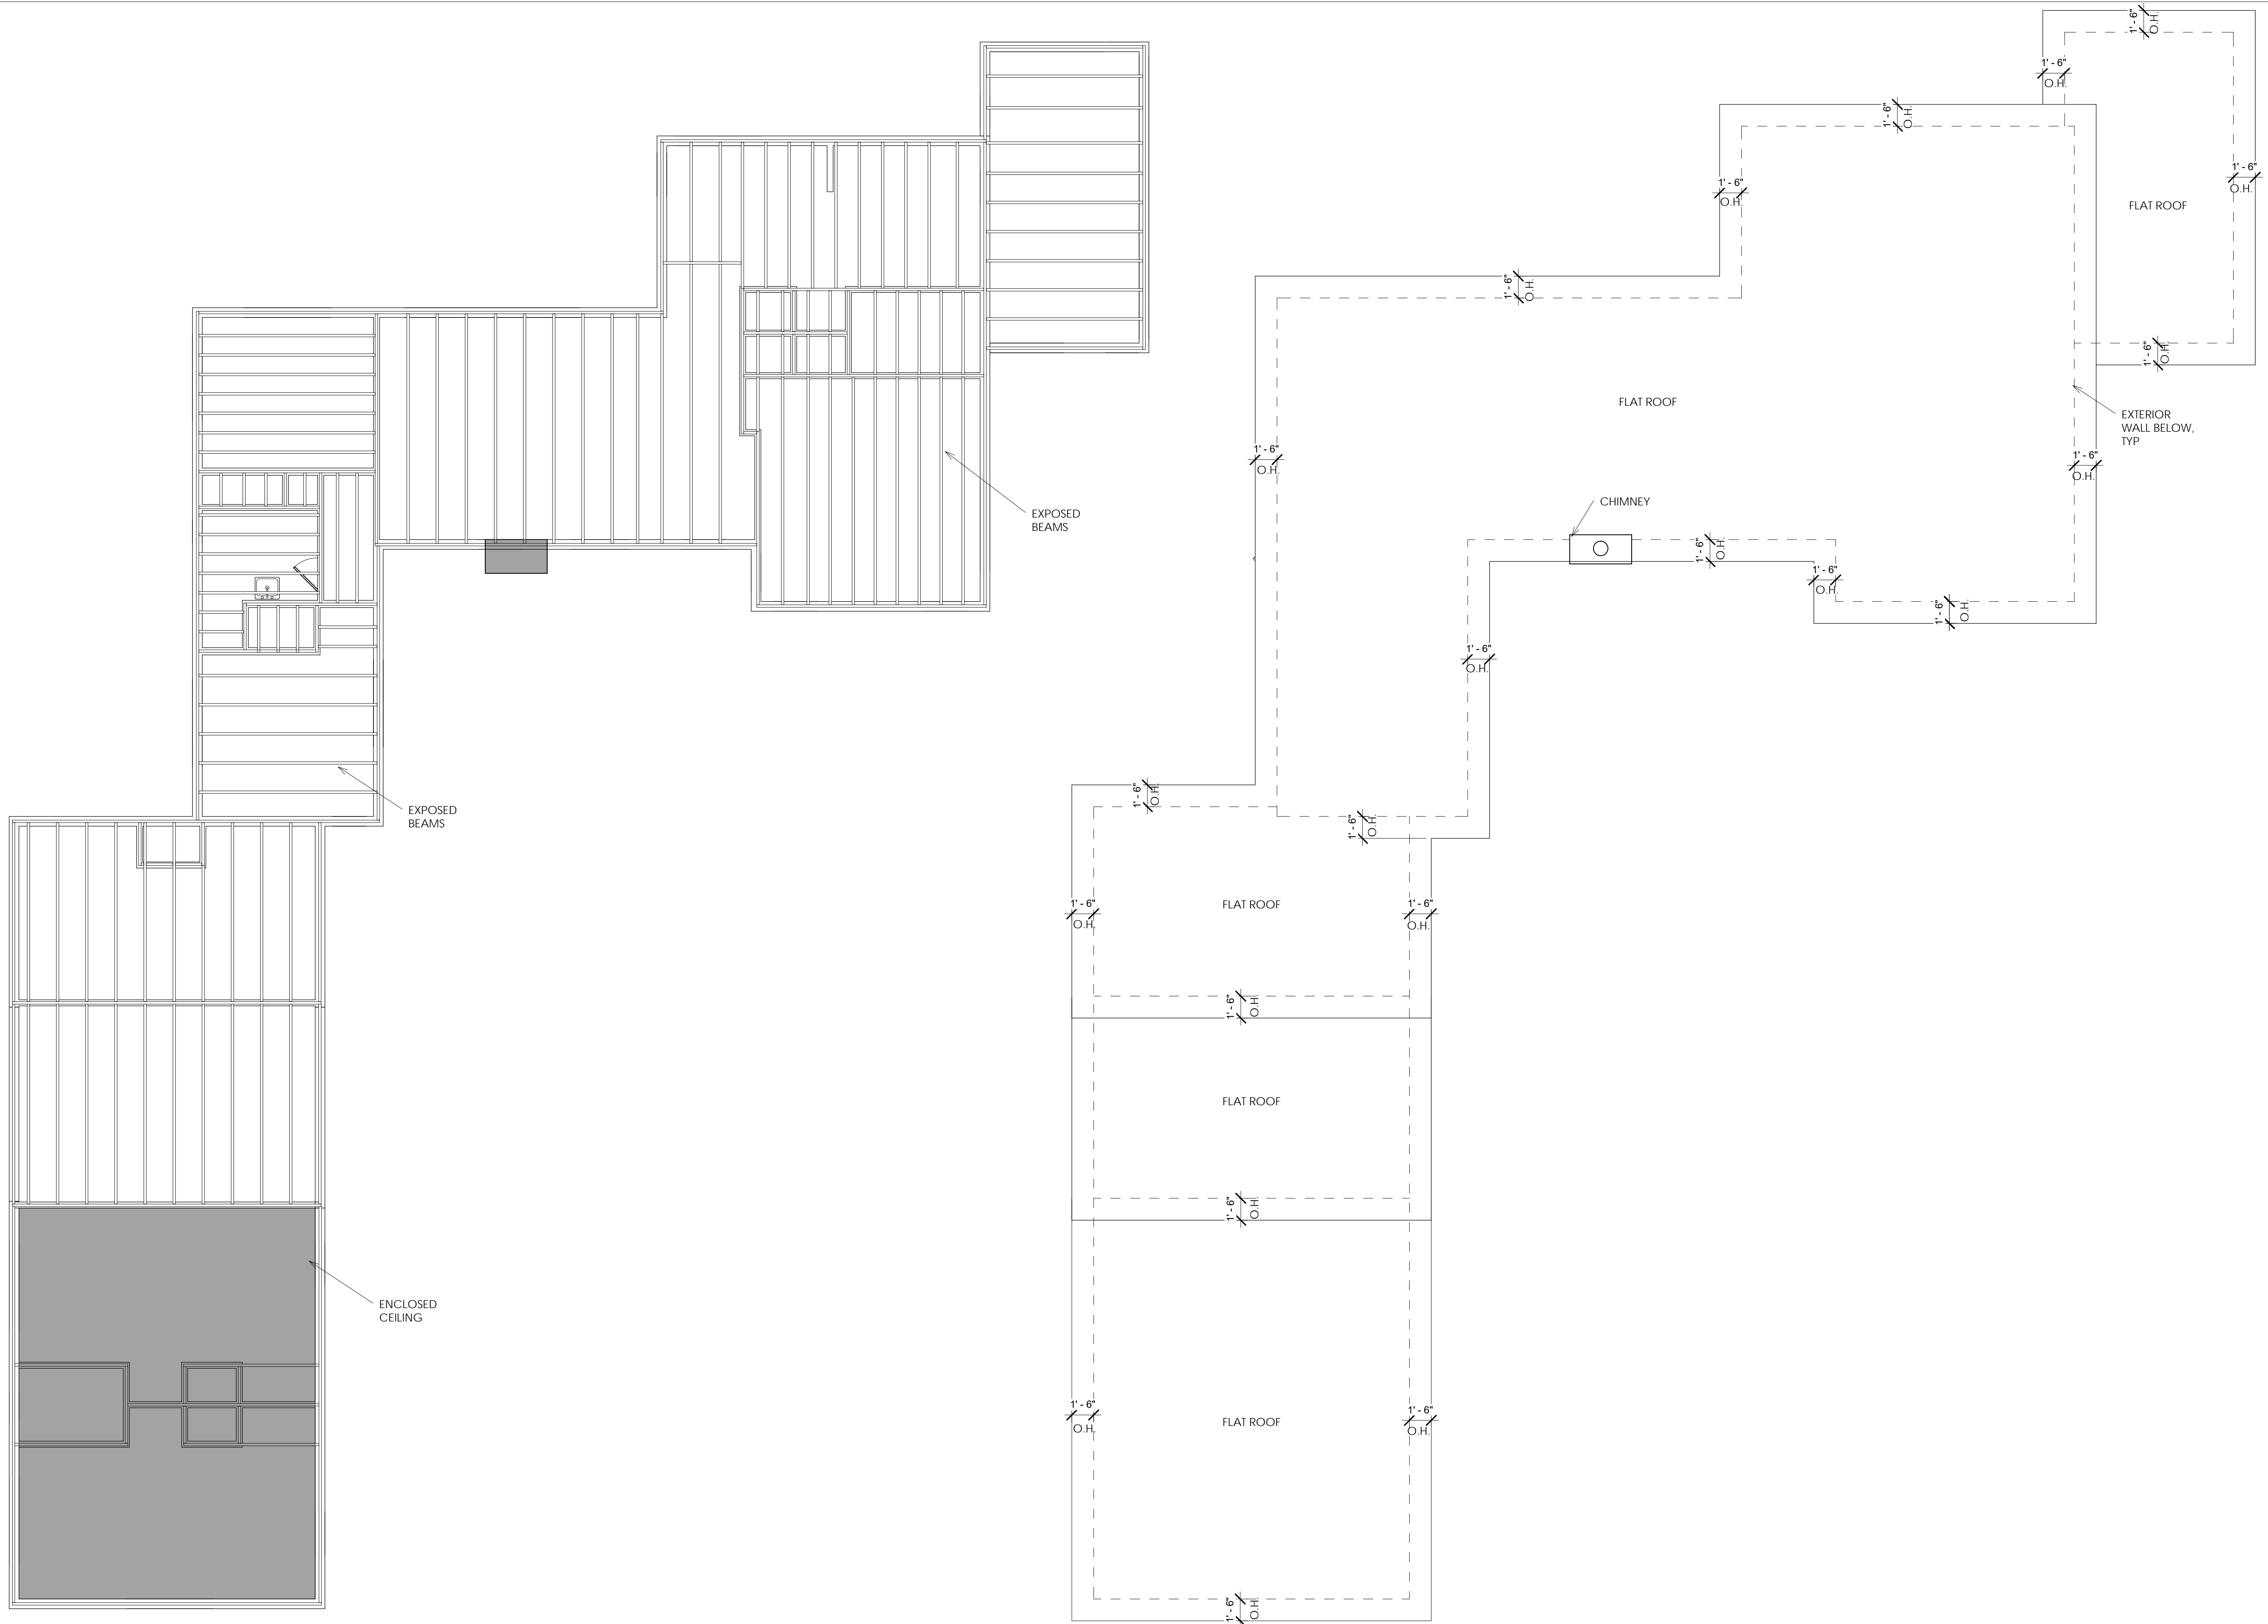


① ROOF FRAMING PLAN
 3/16" = 1'-0"


② ROOF PLAN
 3/16" = 1'-0"

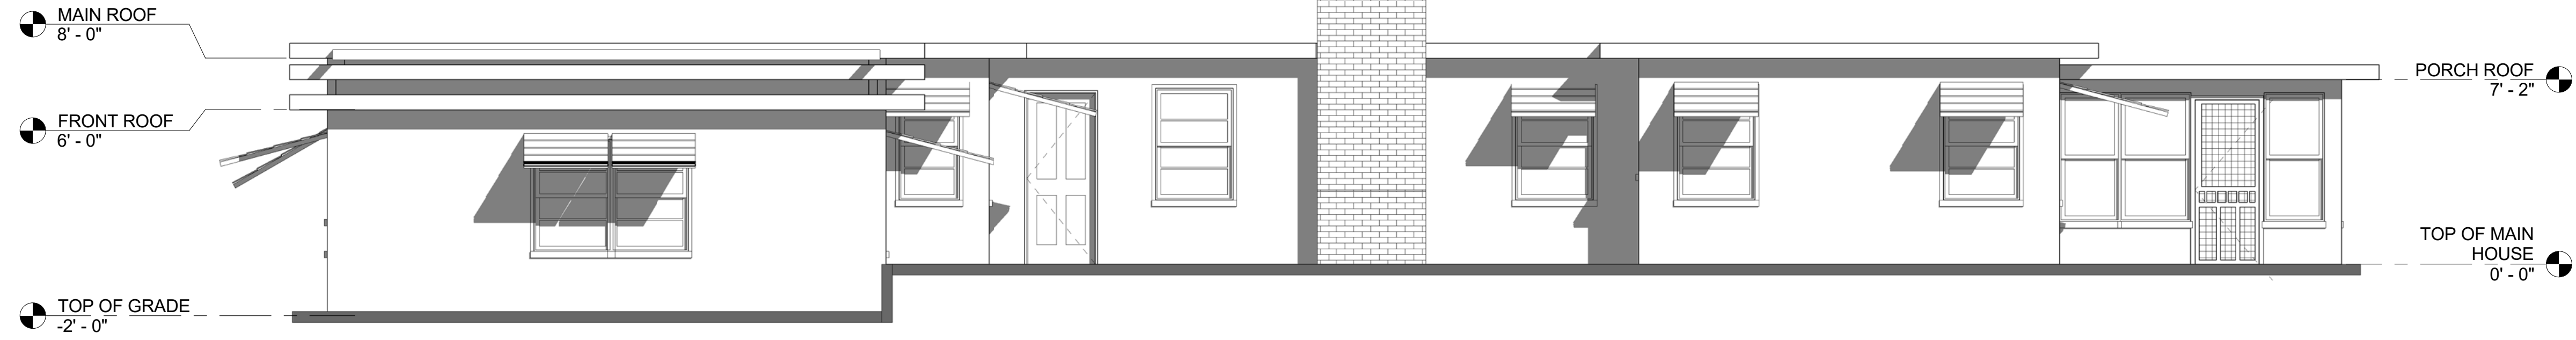


① EXTERIOR ELEVATION 1
 1/4" = 1'-0"

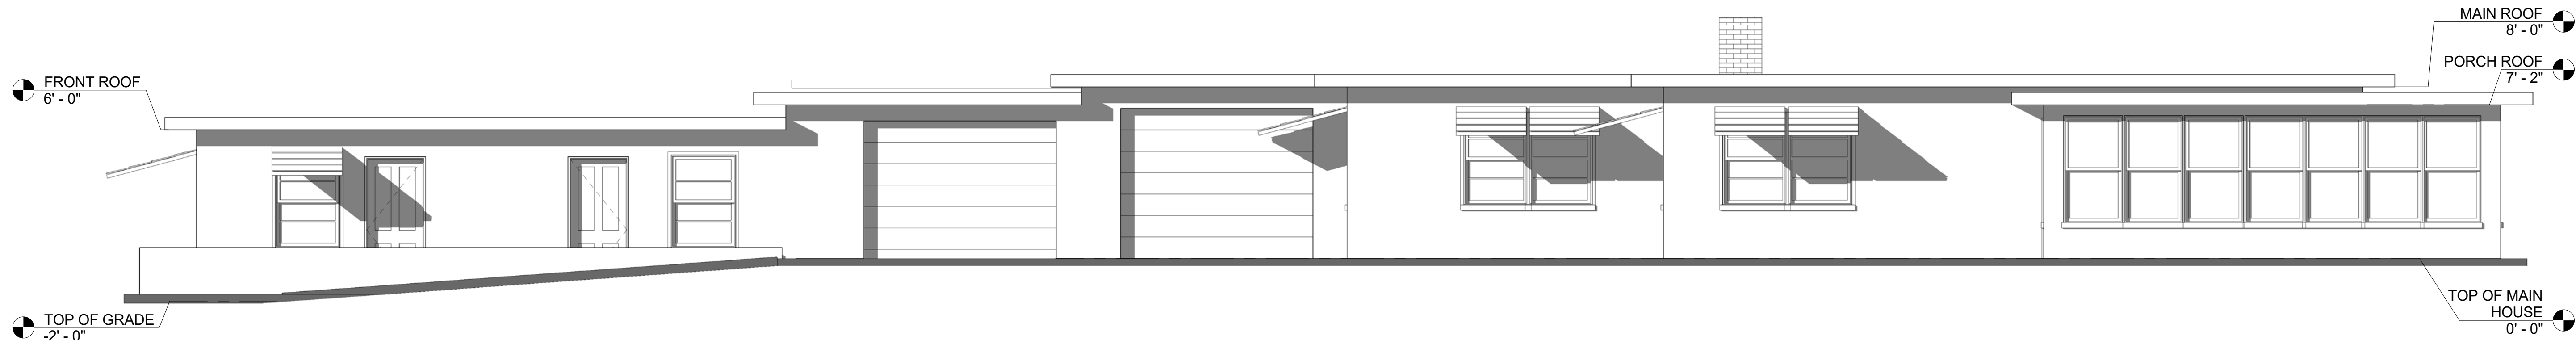

② EXTERIOR ELEVATION 2
 1/4" = 1'-0"

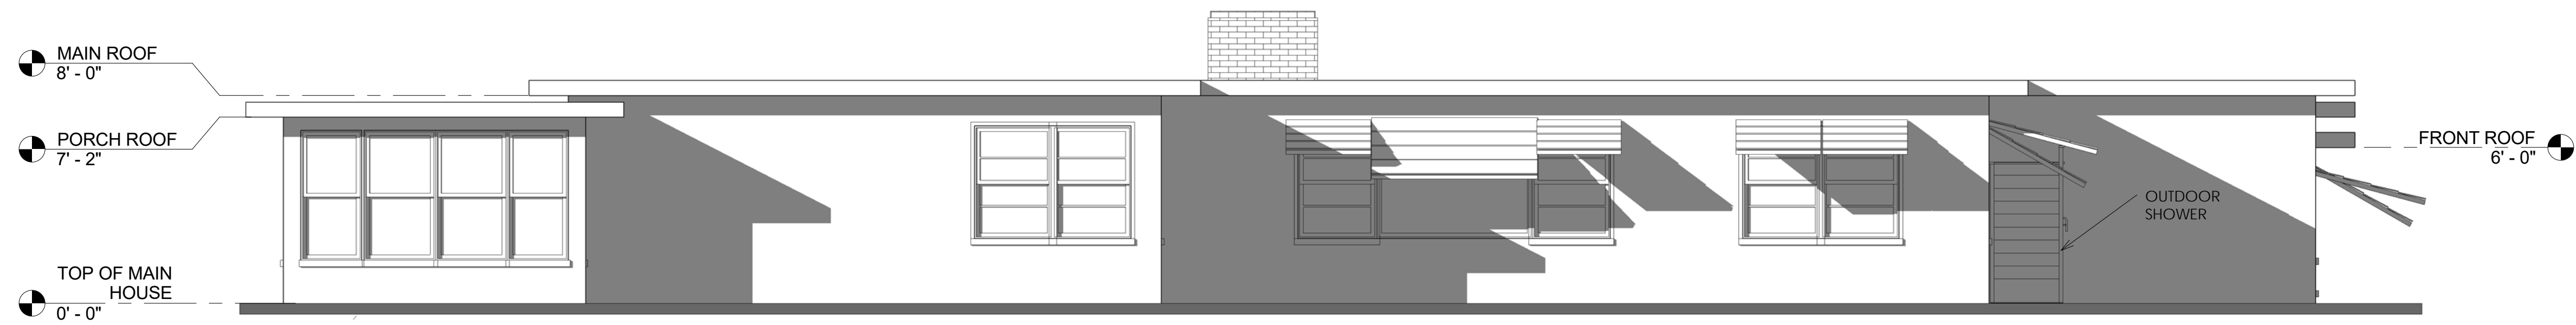

③ EXTERIOR ELEVATION 3
 1/4" = 1'-0"

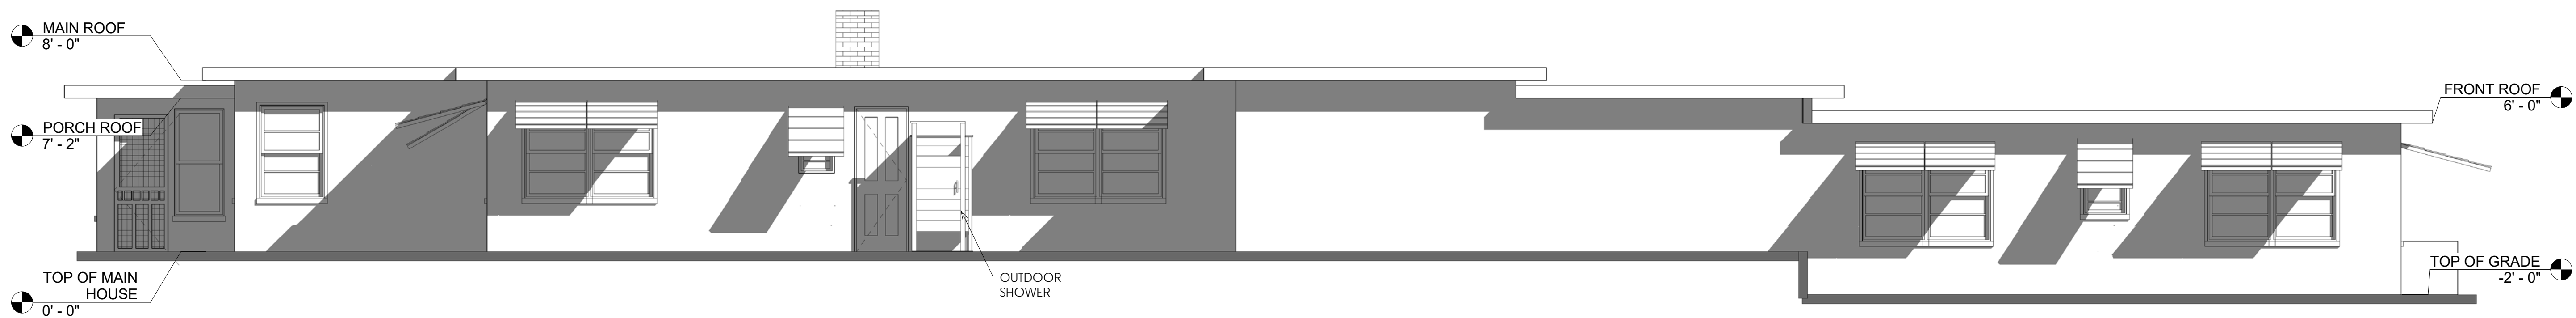

④ EXTERIOR ELEVATION 4
 1/4" = 1'-0"

PROJECT NAME:

 6 YELLOWFIN LANE
 SOUTHERN SHORES
 NORTH CAROLINA

REVISIONS:	DATE:
AS- BUILTS	2 / 25 / 19

DRAWING NAME:

 ELEVATIONS

PRELIMINARY DRAWINGS
 NOT FOR
 CONSTRUCTION:

DRAWN BY: DF
 DATE: 2 / 25 / 19

SCALE: SEE PLANS

STAMP:

© 2016 BEACON ARCHITECTURE + DESIGN P.L.L.C. ALL RIGHTS RESERVED

SHEET:

 A2.1